

MONROE

MISSISSIPPI BOARD OF WATER COMMISSIONERS

K 2000

WATER WELL DRILLERS LOG

HERNDON WELL & SUPPLY CO.

Date: Nov. 7, 1962, Driller: SHANNON P. O. BOX 42 County Monroe  
Name MISSISSIPPI


	Description & Color of Materials Sand, Clay, Red Clay, Shell, etc.	Thick- ness Feet	Depth Feet
(1) Owner of Land: <u>B. C. Gauth</u> <small>(Name)</small> <u>Gibson, Miss.</u> <small>(Address)</small>	<u>surface sand &amp; clay</u>		<u>0</u>
(2) Location: <u>1/4</u> , <u>1/4</u> , Sec <u>19</u> T <u>145</u> R <u>6</u> <u>1</u> miles <u>W</u> of <u>Gibson</u> <small>(distance) (direction) (Nearest Town)</small>	<u>Blue rock</u> <u>sand</u>		<u>18</u> <u>260</u>
(3) Topography: <u>level</u> <small>(Hilly) (Flat) (Level)</small>	<u>Bottom</u>		<u>380</u>
(4) Purpose of Well: <u>Domestic</u> <small>(Domestic Irrigation Municipal, Industrial, Other)</small>			

Information upon completion of well:

- (1) Diameter 5" inches.
- (2) Total Depth 380 feet.
- (3) Water Level 60 feet below top of ground.
- (4) Cased to 25 ft, Size 5 in.
- (5) Screen: Size —, Length —
- (6) Were any formations sealed against pollution?  
— yes, — no.

If YES depth of formation 18 ft  
Why surface sand

Drillers Remarks: \_\_\_\_\_  
\_\_\_\_\_  
\_\_\_\_\_

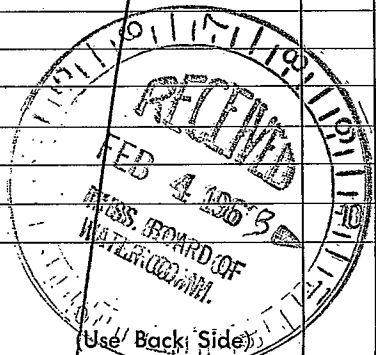

Well No.

11

11

11

11