

MONROE MISSISSIPPI BOARD OF WATER COMMISSIONERS

K 2001  
3-20-65

WATER WELL DRILLERS LOG

Date: March 22, 1965 Driller: Herndon-Homan Well & Supply, Inc. Monroe  
 P. O. Box 32  
 SHANNON, MISSISSIPPI 38868

		Description & Color of Materials Sand, Clay, Red Clay, Shell, etc.	Thick- ness Feet	Depth Feet
(1) Owner of Land:	<u>Richard Rose</u> (Name)			
	<u>Gibson, Miss.</u> (Address)	<u>Black clay</u>	<u>0-4</u>	
(2) Location:	<u>1/4, 1/4, Sec 30 T 14 R 6E</u>	<u>Blue clay sand</u>	<u>4-18</u>	
	<u>3/4 miles W of Aberdeen</u> (distance) (direction) (Nearest Town)	<u>Blue clay</u>	<u>18-280</u>	
(3) Topography:	<u>Flat</u> (Hilly) (Flat) (Level)	<u>sand</u>	<u>280-420</u>	
(4) Purpose of Well:	<u>Domestic</u> (Domestic Irrigation Municipal, Industrial, Other)	<u>Bottom</u>	<u>420</u>	


Information upon completion of well:

- (1) Diameter 4 inches.
- (2) Total Depth 420 feet.
- (3) Water Level 99 feet below top of ground.
- (4) Cased to 21 3/4", Size 4"
- (5) Screen: Size —, Length —
- (6) Were any formations sealed against pollution?  
 yes,  no.

If YES depth of formation 18'

Why surface + sand

Drillers Remarks:  
 \_\_\_\_\_  
 \_\_\_\_\_  
 \_\_\_\_\_

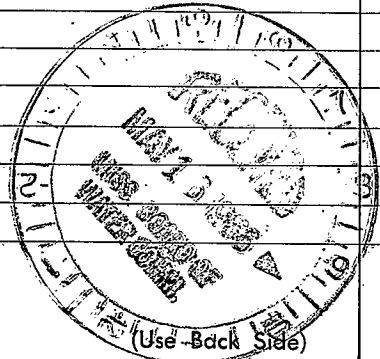

Well No.

