

K 2002
11-21-65

WATER WELL DRILLERS LOG

Herndon-Homan Well & Supply, Inc.

Date: Nov 21, 1965, Driller: P. O. Box 42 County Monroe
SHANNON, MISSISSIPPI 38868

(1) Owner of Land: E. M. Clark
(Name)
Rt. 3 Aberdeen, Miss.
(Address)
(2) Location: 1/4, 1/4, Sec. 11 T. 14S R. 6E
6 miles NW of Aberdeen
(distance) (direction) (Nearest Town)
(3) Topography: Flat
(Hilly) (Flat) (Level)
(4) Purpose of Well: Domestic
(Domestic Irrigation
Municipal, Industrial, Other)


Description & Color of Materials Sand, Clay, Red Clay, Shell, etc.	Thick- ness Feet	Depth Feet
<u>surface sand +</u>		
<u>clay</u>		<u>0-23</u>
<u>red clay</u>		<u>23-58</u>
<u>sand</u>		<u>11-8 240</u>
<u>bottom</u>		<u>240</u>

Information upon completion of well:

(1) Diameter 4 inches.
(2) Total Depth 240 feet.
(3) Water Level 80 feet below top of ground.
(4) Cased to 25' 3", Size 4"
(5) Screen: Size , Length
(6) Were any formations sealed against pollution?
✓ yes, no.

If YES depth of formation 23'
Why surface sand

Drillers Remarks:

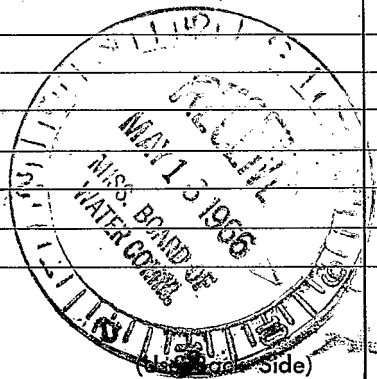

Well No.

... ..

... ..

