

Monroe

K 2003

4-66

MISSISSIPPI BOARD OF WATER COMMISSIONERS

WATER WELL DRILLERS LOG

Herndon-Homan Well & Supply, Inc.

Date: April 27, 1966, Driller: P. O. Box 42, County Monroe, SHANNON, MISSISSIPPI 38658

(1) Owner of Land: Russell Kahl (Name) Gibson, Miss (Address) SE 1/4, NW 1/4, Sec. 19, T14S, R6E (Location) 3/4 miles South of Egypt (distance) (direction) (Nearest Town) (3) Topography: Level (Hilly) (Flat) (Level) (4) Purpose of Well: Domestic (Domestic Irrigation Municipal, Industrial, Other)


Table with 4 columns: Description & Color of Materials, Thickness Feet, Depth Feet. Contains handwritten entries: 'Block surface soil' (9' thickness, 18' depth), 'Blue clay' (162' thickness, 260' depth), 'Sand' (120' thickness, 400' depth). A large wavy line is drawn across the table.

Information upon completion of well:

(1) Diameter 5 inches. (2) Total Depth 400 feet. (3) Water Level 95 feet below top of ground. (4) Cased to 21', Size 5". (5) Screen: Size none, Length. (6) Were any formations sealed against pollution? yes, no.

If YES depth of formation 18' Why Surface & sand

Drillers Remarks: Yield in gpm: 10 Size pump: 3/4 Type power: Electric

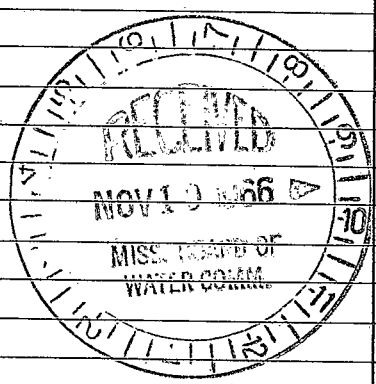

[The page contains extremely faint and illegible text, likely bleed-through from the reverse side of the document. No specific content can be transcribed.]