

**MISSISSIPPI  
BOARD OF WATER COMMISSIONERS**  
416 North State Street  
Jackson, Mississippi 39201

**WATER WELL DRILLERS LOG**

5-29 1967 W. J. REEVES & SON MONROE  
 date well completed firm name county well located

LANDOWNER: L. C. COOK

description of formations encountered

from to

RT. 1

PRAIRIE

(mailing address)

WELL LOCATION:

sec. 4 T. 14 S. R. 6 E.  
10 miles NW of ABERDEEN  
 (distance) (direction) (nearest town)


WELL PURPOSE:  
 (home, irrigation, municipal, industrial)

WELL COMPLETION DATA:

- (1) diameter (inches) 4
- (2) total depth (feet) 309
- (3) static water level (feet) 79 below top of ground.
- (4) casing STEEL, 24 1/2'  
 (material) (depth)  
4" if telescope see back.  
 (size)
- (5) screen NONE  
 (length) (depth to top)  
 (size) (material)
- (6) pump NONE  
 (HP) (yield gpm)  
 (type power)
- (7) electric log NO  
 (yes or no)  
 (organization running log)
- (8) how well bottom plugged OPEN

<u>YELLOW CLAY</u>	<u>0</u>	<u>23</u>
<u>BLUE CLAY</u>	<u>27</u>	<u>172</u>
<u>" SAND</u>	<u>172</u>	<u>190</u>
<u>" CLAY</u>	<u>190</u>	<u>193</u>
<u>" SAND</u>	<u>193</u>	<u>207</u>
<u>" CLAY</u>	<u>207</u>	<u>213</u>
<u>" SAND</u>	<u>213</u>	<u>250</u>
<u>" CLAY</u>	<u>250</u>	<u>262</u>
<u>" SAND</u>	<u>262</u>	<u>309</u>

DRILLERS REMARKS:

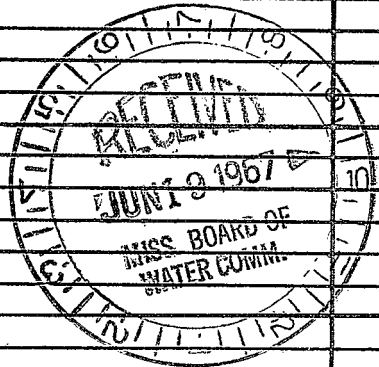

If well telescopes please sketch and show depths.

GROUND LEVEL

X			

SECTION 4

Please indicate well location X.

ADDITIONAL INFORMATION

If more than one screen, show locations of each on sketch.