

MONROE  
 R 2006  
 11-67

MISSISSIPPI  
 BOARD OF WATER COMMISSIONERS  
 416 North State Street  
 Jackson, Mississippi 39201

WATER WELL DRILLERS LOG

11/13/80 1980 ~~Shannon-Homan Well & Supply, Inc.~~ <sup>Sh</sup> ~~Shannon, Mississippi 38988~~ <sup>Monroe</sup>  
 date well completed P. O. Box 42 County well located

LANDOWNER:  
 L.C. Cook (part)  
 Address: Green  
 Egypt, Miss  
 (mailing address)

description of formations encountered	from	to
surface sand & clay	0	30
blue clay	30	220
Sand	220	340
BIT	340	

WELL LOCATION:  
 sec. S T 14 R 6 E  
 S SW CH  
 2 miles E of Egypt  
 (distance) (direction) (nearest town)

WELL PURPOSE: Home  
 (home, irrigation, municipal, industrial)

WELL COMPLETION DATA:

(1) diameter (inches) 4"

(2) total depth (feet) 340'

(3) static water level (feet) 85 below top of ground


(4) casing Steel, 34'  
 (material) (depth)  
 (size) If telescope see back.

(5) screen none  
 (length) (depth to top)  
 (size) (material)

(6) pump none  
 (HP) (yield gpm)  
 (type power)

(7) electric log no  
 (yes or no)  
 (organization running log)

(8) how well bottom plugged open

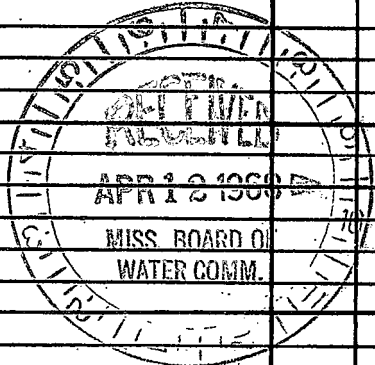

DRILLERS REMARKS:

If well telescopes please sketch and show depths.

GROUND LEVEL

	X		

SECTION 5

Please indicate well location X.

ADDITIONAL INFORMATION

If more than one screen, show locations of each on sketch.