

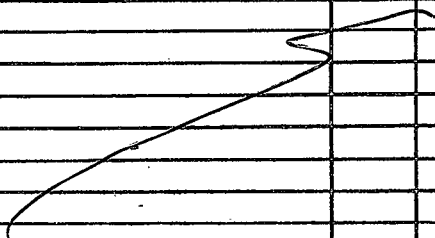
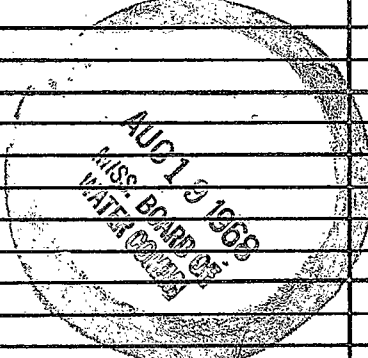
Monroe
R 2007
8-68

MISSISSIPPI
 BOARD OF WATER COMMISSIONERS
 416 North State Street
 Jackson, Mississippi 39201

WATER WELL DRILLERS LOG

Herndon-Homan Well & Supply, Inc. Modjoc
 P. O. Box 42
 STANNON, MISSISSIPPI 39068
 county well located

8-7-68
 date well completed

LANDOWNER:	description of formations encountered	from	to	
<u>Albert W. Davis</u> <u>P.O. Box 114, Aberdeen</u> (mailing address) <u>Miss</u>	<u>Super Clay</u> <u>Blue Clay</u> <u>Sand</u> <u>Gravel</u>	<u>0</u> <u>35</u> <u>280</u> <u>400</u>	<u>35</u> <u>280</u> <u>400</u>	
WELL LOCATION: sec. <u>5</u> T. <u>14</u> N. R. <u>6</u> E <u>1 1/2</u> miles <u>E</u> of <u>Egypt</u> (distance) (direction) (nearest town)				
WELL PURPOSE: <u>Home</u> (home, irrigation, municipal, industrial)				
WELL COMPLETION DATA: (1) diameter (inches) <u>5</u> (2) total depth (feet) <u>400</u> (3) static water level (feet) <u>100</u> below top of ground. (4) casing <u>steel</u> , <u>4 1/2</u> (material) (depth) <u>5 1/2</u> if telescope see back. (size) (5) screen <u>1/2</u> (length), (depth to top) (size) (material) (6) pump <u>1/2</u> (HP), <u>5</u> (yield gpm) <u>electric</u> (type power) (7) electric log <u>NO</u> (yes or no) (organization running log) (8) how well bottom plugged <u>open</u>				
DRILLERS REMARKS:				

If well telescopes please sketch and show depths.

GROUND LEVEL

X			

SECTION 5

Please indicate well location X.

ADDITIONAL INFORMATION

If more than one screen, show locations of each on sketch.