

MONROE
K 2008
2-5-76

MISSISSIPPI
BOARD OF WATER COMMISSIONERS
416 North State Street
Jackson, Mississippi 39201

WATER WELL DRILLERS LOG

Herman Homan Well & Supply, Inc.

P. O. Box 42

SHANNON, MISSISSIPPI 38868

county well located

7/5
date well completed

134

76

Monroe


LANDOWNER:	description of formations encountered	from	to
Bessie Meritt R 3, Aberdeen Miss (mailing address)	Surface sand Clay Shale clay Sand Bottom	0	35 240 240380 580
WELL LOCATION: sec. 4 T. 14 N R. 13 E S 1 1/2 miles NE of Gibson (distance) (direction) (nearest town)			
WELL PURPOSE: (home, irrigation, municipal, industrial)			
WELL COMPLETION DATA: (1) diameter (inches) 4" (2) total depth (feet) 380 (3) static water level (feet) 11 below top of ground (4) casing Steel, 42' (material), (depth) 4" (size) If telescope see back. (5) screen NO (length) (depth to top) (size) (material) (6) pump 1/2 (HP) 5 (yield gpm) electric (type power) (7) electric log NO (yes or no) (organization running log) (8) how well bottom plugged open			
DRILLERS REMARKS:			

RECEIVED
MAR 10 1976

MISS. BU. OF WATER CONTROL

If well telescopes please sketch and show depths.

GROUND LEVEL

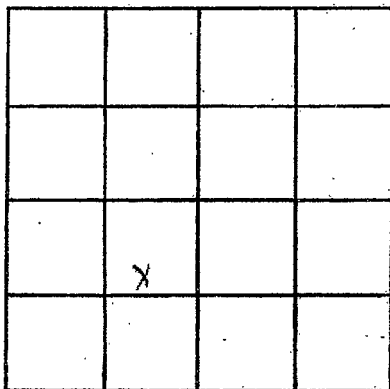

SECTION 4

Please indicate well location X.

ADDITIONAL INFORMATION

If more than one screen, show locations of each on sketch.