

MONROE
 R 2009
 2-6-76

MISSISSIPPI
 BOARD OF WATER COMMISSIONERS
 416 North State Street
 136 Jackson, Mississippi 39201

WATER WELL DRILLERS LOG

2-4
 date well completed

1976 Herman Homan Well & Supply, Inc.
 Firm No. 42

Monroe
 county well located


SHANNON, MISSISSIPPI 39360

LANDOWNER:	description of formations encountered	from	to
Jerry Farhee #3, Aberdeen, Miss (mailing address)	surface sand & clay blue clay sand Bottom	0 35 240 370	35 240 370
WELL LOCATION: sec. 4 T. 44 N. R. 6 E S. W. 4 1/2 miles NE of Gibson (distance) (direction) of (nearest town)			
WELL PURPOSE: (home, irrigation, municipal, industrial) Home			
WELL COMPLETION DATA:			
(1) diameter (inches) 4 1/2			
(2) total depth (feet) 370'			
(3) static water level (feet) 112 below top of ground.			
(4) casing (material) Steel (depth) 22' 4" if telescope see back. (size)			
(5) screen (length) 10 (depth to top) (size) (material)			
(6) pump (HP) 1/2 (yield gpm) 5 electric (type power)			
(7) electric log (yes or no) no			
(organization running log)			
(8) how well bottom plugged 67%			
DRILLERS REMARKS:			

RECORDED
 MAR 10 1976

If well telescopes please sketch and show depths.

GROUND LEVEL

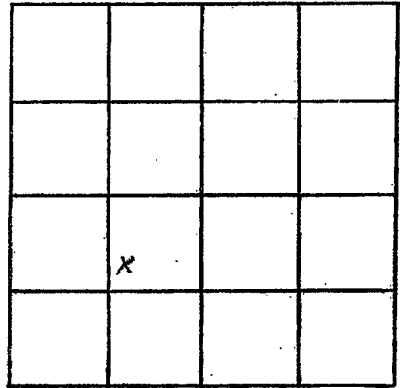

SECTION _____

Please indicate well location X.

ADDITIONAL INFORMATION

If more than one screen,
show locations of each on sketch.