

Monroe  
K 2012  
7/22/76

MISSISSIPPI  
BOARD OF WATER COMMISSIONERS  
416 North State Street  
Jackson, Mississippi 39201

WATER WELL DRILLERS LOG

Herman Homan Well & Supply, Inc.  
P. O. Box 42

SHANNON, MISSISSIPPI 38868

Monroe  
county well located

7/22 1976  
date well completed


LANDOWNER:	description of formations encountered	from	to
James Creek Ranch Box 794, Aberdeen, Ms (mailing address)	sandstone and blue clay sand bottom	0 16 180 360	16 180 360
<b>WELL LOCATION:</b> sec. <u>2</u> T. <u>14</u> N. R. <u>6</u> E. <u>4</u> miles <u>NW</u> of <u>Aberdeen</u> (distance) (direction) (nearest town)			
<b>WELL PURPOSE:</b> <u>for BASIN</u> (home, irrigation, municipal, industrial)			
<b>WELL COMPLETION DATA:</b>			
(1) diameter (inches) <u>5"</u>			
(2) total depth (feet) <u>360'</u>			
(3) static water level (feet) <u>182</u> below above top of ground.			
(4) casing <u>steel</u> , <u>216'</u> (material) (depth) <u>5"</u> (size) if telescope see back.			
(5) screen <u>ND</u> , (length) (depth to top)  (size) (material)			
(6) pump <u>1 1/2</u> <u>10</u> (HP) (yield gpm). <u>electric</u> (type power)			
(7) electric log <u>ND</u> (yes or no)			
(organization running log)			
(8) how well bottom plugged <u>open</u>			
<b>DRILLERS REMARKS:</b>			

RECEIVED  
AUG 16 1976

MISS. BD. OF WATER COMMISSIONERS

If well telescopes please sketch and show depths.

GROUND LEVEL

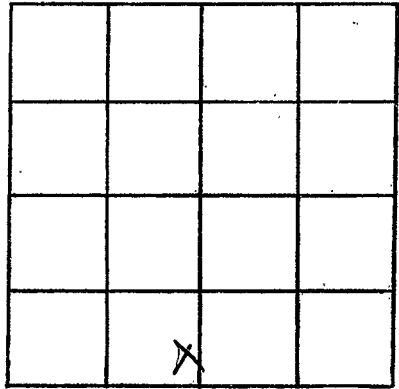

SECTION 2

Please indicate well location X.

ADDITIONAL INFORMATION

If more than one screen, show locations of each on sketch.