

MONROE  
K 2013  
8/16/76

MISSISSIPPI  
 BOARD OF WATER COMMISSIONERS  
 416 North State Street  
 Jackson, Mississippi 39201

WATER WELL DRILLERS LOG  
 Herman Homan Well & Supply, Inc.

8/16 1976 date well completed  
 P. O. Box 42  
 SHANNON, MISSISSIPPI 38668  
Monroe county well located

LANDOWNER:  
R. L. Staples  
Rt 3, Aberdeen, MS  
 (mailing address)

description of formations encountered	from	to
Surface sand	0	16
Blue clay	16	150
Sand	150	270
BD	270	

WELL LOCATION:  
 sec. 13 T. 14 N. R. 6 E.  
3 miles SW of Aberdeen  
 (distance) (direction) (nearest town)

WELL PURPOSE:  
Home  
 (home, irrigation, municipal, industrial)

WELL COMPLETION DATA:

(1) diameter (inches) 4 1/2

(2) total depth (feet) 270

(3) static water level (feet) 120 <sup>below</sup> / <sub>above</sub> top of ground.

(4) casing steel, 21'  
 (material) (depth)  
8"  
 (size) if telescope see back.

(5) screen NO  
 (length) (depth to top)  
 (size) (material)

(6) pump 1/2 (HP) 5 (yield gpm)  
elect  
 (type power)

(7) electric log NO  
 (yes or no)  
 (organization running log)


(8) how well bottom plugged Yes

DRILLERS REMARKS:

**RECEIVED**  
 SEP 20 1976

If well telescopes please sketch and show depths.

GROUND LEVEL

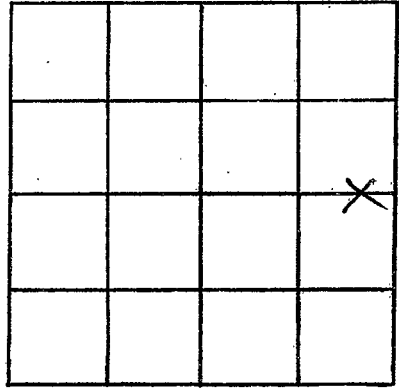

SECTION 13

Please indicate well location X.

ADDITIONAL INFORMATION

If more than one screen,  
show locations of each on sketch.