

MONROE
K 2014
10-29-76

MISSISSIPPI
 BOARD OF WATER COMMISSIONERS
 416 North State Street
 Jackson, Mississippi 39201

WATER WELL DRILLERS LOG

10/29 1976 Herman Homan Well & Supply, Inc. Monroe
 date well completed 134 P.O. Box 42 county well located

SHANNON, MISSISSIPPI 38602

LANDOWNER: Johnny Gaddoo
R3 Aberdeen, Ms
 (mailing address)

WELL LOCATION:
 sec. 3 T. 14 N. R. 6 E.
S W
3 miles East of Egypt
 (distance) (direction) (nearest town)

WELL PURPOSE: Home
 (home, irrigation, municipal, industrial)

- WELL COMPLETION DATA:
- (1) diameter (inches) 4 1/2
 - (2) total depth (feet) 360
 - (3) static water level (feet) 502 below above top of ground.
 - (4) casing steel PI
 (material) (depth)
4 1/2 If telescope see back.
 (size)
 - (5) screen no
 (length) (depth to top)
 (size) (material)
 - (6) pump 1/2 5
 (HP) (yield gpm)
electric
 (type power)
 - (7) electric log no
 (yes or no)
- (organization running log)
- (8) how well bottom plugged open

DRILLERS REMARKS:

description of formations encountered	from	to
surface sand		
clay	0	35
blue clay	35	270
sand	270	360
bottom	360	


RECEIVED

NOV 29 1976

MISS. BD. OF WATER COMMISSIONERS

If well telescopes please sketch and show depths.

GROUND LEVEL

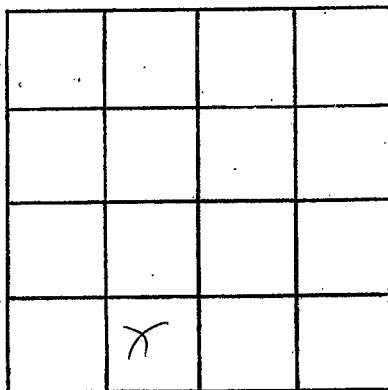

SECTION 3

Please indicate well location X.

ADDITIONAL INFORMATION

If more than one screen,
show locations of each on sketch.