

Monroe
K 2015
11/28/77

MISSISSIPPI
BOARD OF WATER COMMISSIONERS
416 North State Street
Jackson, Mississippi 39201

WATER WELL DRILLERS LOG

11-28 1977 date well completed
Herman Homan Well & Supply, Inc.
firm name
SHANNON MISSISSIPPI 38-68
Monroe county well located

LANDOWNER:
Bessie McClinton
Rt 3 Aberdeen Ms.
(mailing address)


description of formations encountered	from	to
surface sand	0	16
blue clay	16	220
sand	220	360
bottom	360	

WELL LOCATION:
sec. 9 T 14 N R 6 E
3 miles NE of G. Wood
(distance) (direction) (nearest town)

WELL PURPOSE: Home
(home, irrigation, municipal, industrial)

- WELL COMPLETION DATA:
- (1) diameter (inches) 4"
 - (2) total depth (feet) 360'
 - (3) static water level (feet) 147' below top of ground.
 - (4) casing steel, 21' (material) (depth)
4" if telescope see back. (size)
 - (5) screen NO (length) (depth to top)
(size) (material)
 - (6) pump 1/2 HP 5 (HP) (yield gpm)
electric (type power)
 - (7) electric log NO (yes or no)
 - (organization running log)
 - (8) how well bottom plugged open


DRILLERS REMARKS:

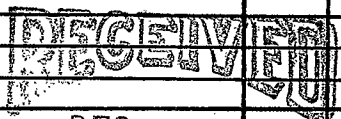

DEC 22 1977

If well telescopes please sketch and show depths.

GROUND LEVEL

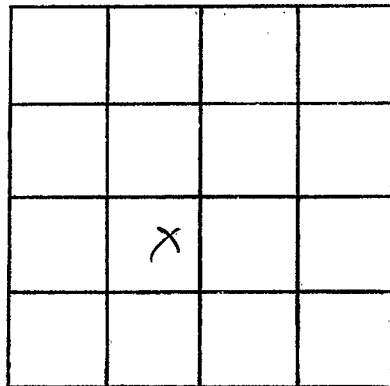

SECTION 9

Please indicate well location X.

ADDITIONAL INFORMATION

If more than one screen,
show locations of each on sketch.