

Monroe
K 2017
12/15/77

MISSISSIPPI
BOARD OF WATER COMMISSIONERS
416 North State Street
Jackson, Mississippi 39201

WATER WELL DRILLERS LOG

12-15-77 date well completed 1977 Herman Homan Well & Supply, Inc. firm, No. 42 Monroe county well located

LANDOWNER:
Carolyn Wilson
Rt 3 Abbeville, MS.
(mailing address)

description of formations encountered	from	to
Surface sand		
Blue clay	0	35
Sand	35	200
Gravel	200	320
	320	

WELL LOCATION:
sec. 3 T. 13 N. R. 6 E.
5 14 S. miles NE of Abbeville
(distance) (direction) (nearest town)

WELL PURPOSE:
(home, irrigation, municipal, industrial)

- WELL COMPLETION DATA:
- (1) diameter (inches) 4"
 - (2) total depth (feet) 320'
 - (3) static water level (feet) 136' below top of ground.
 - (4) casing (material) steel, (depth) 42', (size) 4" if telescope see back.
 - (5) screen (length) 20', (depth to top) (size) (material)
 - (6) pump (HP) 1/2, (yield gpm) 5, (type power) electric
 - (7) electric log (yes or no) NO
(organization running log)
 - (8) how well bottom plugged open


RECEIVED
DEC 22 1977

DRILLERS REMARKS:

MISS. BD. OF WATER COMM.

If well telescopes please sketch and show depths.

GROUND LEVEL

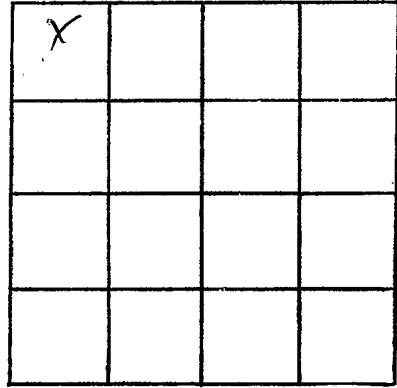

SECTION 3

Please indicate well location X.

ADDITIONAL INFORMATION

If more than one screen, show locations of each on sketch.