

MONROE  
K 2018  
2/15/78

MISSISSIPPI  
BOARD OF WATER COMMISSIONERS  
416 North State Street  
Jackson, Mississippi 39201

WATER WELL DRILLERS LOG

2-15-1978 date well completed Herman Homan Well & Supply, Inc. P. O. Box 26  
Monroe county well located  
 SHANNON, MISSISSIPPI 38668

LANDOWNER: Peterson Job  
David E. Wray  
Rt 2 Okolona, MS  
 (mailing address)

description of formations encountered	from	to
surface sand		
blue clay	0	16
blue clay	16	240
sand	240	380
BTW	380	

WELL LOCATION:  
 sec. 30 T. 14 N. R. 6 E  
S W  
1 miles W of Gibson  
 (distance) (direction) (nearest town)

WELL PURPOSE: Home  
 (home, irrigation, municipal, industrial)

- WELL COMPLETION DATA:
- (1) diameter (inches) 4 1/2
  - (2) total depth (feet) 380
  - (3) static water level (feet) 140 below top of ground.
  - (4) casing steel (material), 2 1/2" (depth)  
4 1/2" (size) if telescope see back.
  - (5) screen no (length), (depth to top)  
 (size) (material)
  - (6) pump 1/2 (HP), 5 (yield gpm)  
electric (type power)
  - (7) electric log no (yes or no)  
 (organization running log)
  - (8) how well bottom plugged open


RECEIVED  
 MAR 23 1978

DRILLERS REMARKS:

MISS. BD. OF WATER COMMISSIONERS

If well telescopes please sketch and show depths.

GROUND LEVEL

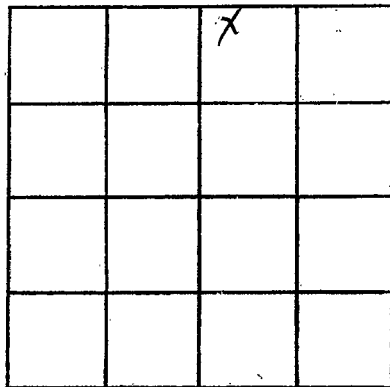

SECTION 30

Please indicate well location X.

ADDITIONAL INFORMATION

If more than one screen, show locations of each on sketch.