

MONROE
K 2020
11-22-78

**MISSISSIPPI
BOARD OF WATER COMMISSIONERS**
416 North State Street
Jackson, Mississippi 39201

WATER WELL DRILLERS LOG

11/22 1978 Herman Homan Well & Supply, Inc. Monroe
 date well completed firm name, Box 42 county well located

LANDOWNER:
Roosevelt Edward
43 Aberdeen, Ms
 (mailing address)

description of formations encountered	from	to
surface clay	0	16
Blue clay	16	200
Sand	20	340
Bottom	340	

WELL LOCATION:
 sec. 10 T. 4 N. R. 6 E.
5 1/2 miles W of FRANK
 (distance) (direction) (nearest town)

WELL PURPOSE: Home
 (home, irrigation, municipal, industrial)

WELL COMPLETION DATA:

(1) diameter (inches) 5"

(2) total depth (feet) 340'

(3) static water level (feet) 102' below above top of ground.

(4) casing Steel, 21' 3"
 (material) (depth)
5" if telescope see back.
 (size)


(5) screen no
 (length) (depth to top)
 (size) (material)

(6) pump 1/4 5
 (HP) (yield gpm)
electric
 (type power)

(7) electric log no
 (yes or no)
 (organization running log)

(8) how well bottom plugged open

DRILLERS REMARKS:

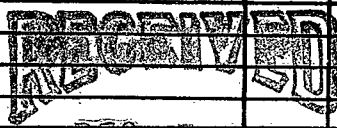

DEC 27 1978

