

MISSISSIPPI DEPARTMENT OF NATURAL RESOURCES

Bureau of Land and Water Resources

Southport Mall

P.O. Box 10631

Jackson, Mississippi 39209

WATER WELL DRILLERS LOG

K 222
MONROE
4-16-85

4-16-1985 date well completed Leeper Drilling firm name Monroe county well located

LANDOWNER: George LUKER
JAMES Creek Ranch Road
Aberdeen, MS
 (mailing address)


description of formations encountered	from	to
<u>TOP clay</u>	<u>0</u>	<u>20</u>
<u>BLUE clay</u>	<u>20</u>	<u>70</u>
<u>GREEN SAND</u>	<u>70</u>	<u>290</u>
<u>WHITE SAND</u>	<u>290</u>	<u>340</u>

WELL LOCATION:
 sec. 12 T. 14 N. R. 6 (E) W
4 miles (distance) N.W. (direction) of Aberdeen (nearest town)

WELL PURPOSE: Home
 (home, irrigation, municipal, industrial)

- WELL COMPLETION DATA:
- (1) diameter (inches) 4
 - (2) total depth (feet) 340
 - (3) static water level (feet) 10.5 below top of ground. above
 - (4) casing PVC 330
 (material) (depth)
4 if telescope see back.
 (size)
 - (5) screen 10' 330'
 (length) (depth to top)
4" PVC
 (size) (material)
 - (6) pump 1 12
 (HP) (yield gpm)
electric
 (type power)
 - (7) electric log NO
 (yes or no)
 - (organization running log)
 - (8) how well bottom plugged well CAP


DRILLERS REMARKS: _____

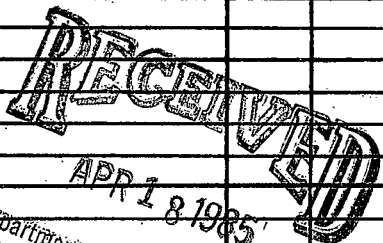

Department of Natural Resources
 Bureau of Land & Water Resources

If well telescopes please sketch and show depths.

GROUND LEVEL

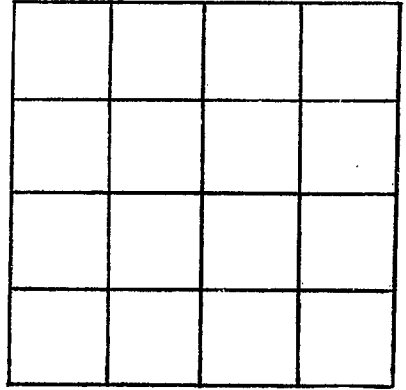

SECTION _____

Please indicate well location X.

ADDITIONAL INFORMATION

If more than one screen,
show locations of each on sketch.