

MISSISSIPPI DEPARTMENT OF ENVIRONMENTAL QUALITY
Bureau of Land and Water Resources

P. O. Box 10631
Jackson, MS 39289-0631
WATER WELL DRILLERS LOG

COUNTY WELL LOCATED Monroe	
WELL NUMBER 1	CODED
K232	
DATE WELL COMPLETED 7/30/97	

PERMIT NUMBER
NAME OF DRILLING FIRM Herndon Well + Supply
Shannon, MS

NAME & MAILING ADDRESS OF LANDOWNER Ross Koehn		
20490 Egypt Rd		
Aberdeen, MS 39730		
WELL LOCATION: SEC	TOWNSHIP	RANGE
13	14	6
DISTANCE 1 1/2 Miles	DIRECTION W	NEAREST TOWN Aberdeen
OTHER LANDMARK		
WELL PURPOSE: Home, Irrigation, Municipal, Industrial, Fish Pond, etc. Home		

PUMP DATA		
PUMP TYPE (Circle One): Submersible , Turbine, Jet, Flowing Well, Other (Describe) _____		
POWER TYPE (Circle One): Electric , Tractor, Diesel, Gasoline, Butane, Other (Describe) _____ H/P 7		
Pump Capacity (GPM) 7	No. of Stages 15	Setting Depth 147 FT.
PUMP TEST		
Well yielded _____ GPM with a drawdown of _____ ft. after _____ hours of pumping		

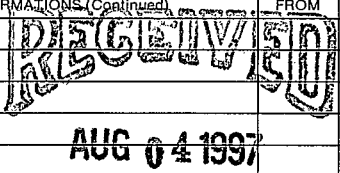
WELL DATA		
Well Depth 360'	Casing Diameter (In.) 5"	Casing Length (Ft.) 42'
Type of Casing Steel	Hole Depth 360'	Depth to Static Water Level 89'
TYPE OF COMPLETION: (Circle One or More): Gravel Packed, Underreamed, Telescoped, Natural Development, Open Hole, Other (Describe) _____		
Top of Lap Pipe or Reduction in Casing		
FEET IF TELESCOPED OR MORE THAN ONE SCREEN: USE BACK PAGE		

LOG DATA	
TYPE OF LOG RUN (Circle One): Electric, Gamma Ray, Density, Sonic, Neutron, Other (Describe) _____ No Log Run	
Name of Organization Running Log	

SCREEN DATA		
Diameter - Inches	Length - Feet	Slot Size - Inches
Screen Type	Depth to Bottom - Feet	

GEOLOGIC DATA (Office Use Only)			
Surface Elev.	Geologic Unit	Unit Thickness	Depth to Top
Subs. SWL	Date	Analysis	Aquifer Test

Driller's Remarks

DESCRIPTION OF FORMATIONS ENCOUNTERED	FROM	TO	FORMATIONS (Continued)	FROM	TO
Brown Clay	0	18			
Blue Clay	18	160			
Sandy Blue Clay	160	220			
SAND	220	335			
Clay + Sand	335	360			
@ 280' Rock 1 1/2"					
IF MORE SPACE IS NEEDED, USE BACK					

Dept. of Environmental Quality
Office of Land & Water Resources

If well telescopes please
sketch and show depths.

GROUND LEVEL

SECTION _____

Please indicate well location X.

ADDITIONAL INFORMATION

If more than one screen,
show location of each on sketch.