

*Monroe*  
~~L~~

MISSISSIPPI DEPARTMENT OF NATURAL RESOURCES  
 Bureau of Land and Water Resources  
 Southport Mall  
 P.O. Box 10631  
 Jackson, Mississippi 39209  
**WATER WELL DRILLERS LOG**

*October* 19*84* *PARKS & PARKS Well* *MONROE*  
 date well completed firm name county well located

LANDOWNER:	description of formations encountered	from	to
<i>D. G. Roberts, Jr.</i> <i>P.O. Box 416</i> <i>Aberdeen, Ms 39730</i> (mailing address)			
WELL LOCATION:			
sec. <i>14</i> T. <i>14</i> S. R. <i>19</i> W.	<i>Butter clay</i>	<i>153</i>	<i>143</i>
<i>1 1/2</i> miles <i>NE</i> of <i>Aberdeen</i> (distance) (direction) (nearest town)			
WELL PURPOSE: <i>Private development</i> (home, irrigation, municipal, industrial)			
WELL COMPLETION DATA:			
(1) diameter (inches)			
(2) total depth (feet)			
(3) static water level (feet) <i>6</i> below top of ground.			
(4) casing <i>20"</i> <i>22'</i> (material) (depth)			
<i>8"</i> if telescope see back. (size)			
(5) screen <i>20'</i> <i>25'</i> (length) (depth to top)			
<i>8"</i> <i>PVC</i> (size) (material)			
(6) pump <i>7 1/2</i> <i>110 +</i> (HP) (yield gpm)			
<i>elec</i> (type power)			
(7) electric log <i>140</i> (yes or no)			
(organization running log)			
(8) how well bottom plugged <i>pipe cap</i>			

RECEIVED


FEB 22 1989

Department of Natural Resources  
 Bureau of Land & Water Resources

DRILLERS REMARKS: *Top of casing extended above ground to elev 198, which is above 100 yr flood.*

If well telescopes please sketch and show depths.

GROUND LEVEL

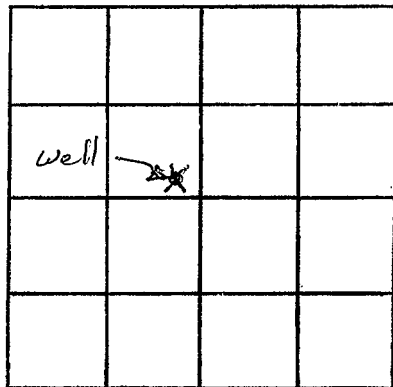

SECTION 14

Please indicate well location X.

ADDITIONAL INFORMATION

If more than one screen,  
show locations of each on sketch.