

L

5-12-62

WATER WELL DRILLERS LOG

Date: May 12, 1962 Driller: HERNDON WELL & SUPPLY CO. County: Monroe  
P. O. BOX 42  
(Name)  
SHANNON, MISSISSIPPI


(1) Owner of Land: <u>Bradley Lumbert</u> (Name)	Description & Color of Materials Sand, Clay, Red Clay, Shell, etc.	Thick- ness Feet	Depth Feet
(Contractor) <u>A. Budee, Miss</u> (Address)	<u>Surface sand &amp; clay</u>		<u>0</u>
(2) Location: $\frac{1}{4}$ , $\frac{1}{4}$ Sec. <u>4 145</u> T <u>9E</u> R <u>7E</u> <u>4</u> miles <u>NW</u> of <u>Abedee</u> (distance) (direction) (Nearest Town)	<u>Blue rock</u>		<u>85</u>
(3) Topography: <u>Flat</u> (Hilly) (Flat) (Level)	<u>Sand</u>		<u>100</u>
(4) Purpose of Well: <u>Domestic</u> (Domestic Irrigation Municipal, Industrial, Other)	<u>Bottom</u>		<u>220</u>

Information upon completion of well:

- (1) Diameter 4 inches.
- (2) Total Depth 220 feet.
- (3) Water Level 50 feet below top of ground.
- (4) Cased to 88', Size 4"
- (5) Screen: Size     , Length
- (6) Were any formations sealed against pollution?  
 yes,  no.

If YES depth of formation 85'  
Why Surface & ~~rock~~ sand

Drillers Remarks:     

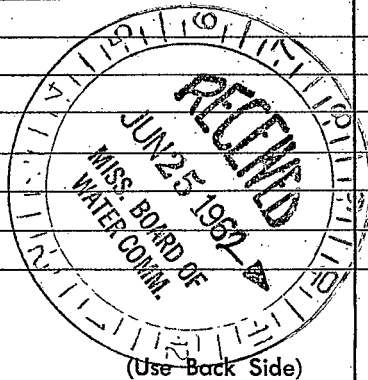

Well No.

*[The page contains extremely faint and illegible text, likely bleed-through from the reverse side of the document. The text is mostly centered and appears to be a list or series of entries.]*

7