

MONROE MISSISSIPPI BOARD OF WATER COMMISSIONERS

L31

Coled

WATER WELL DRILLERS LOG

11-28-64

Date: Nov. 28, 19 64, Driller: Carloss Well Supply County Monroe

(Name)

(1) Owner of Land: City of Aberdeen
(Name)

Aberdeen, Mississippi

(Address)

Well # 5 -- (Meadow Lane)

(2) Location: 1/4, 1/4, Sec. T R

 miles of
(distance) (direction) (Nearest Town)

(3) Topography: (Hilly) (Flat) (Level)

(4) Purpose of Well: Municipal
(Domestic Irrigation
Municipal, Industrial, Other)

Description & Color of Materials Sand, Clay, Red Clay, Shell, etc.	Thick- ness Feet	Depth Feet
Red Clay	6'	6'
Brown Clay	16'	22'
Gray Sand	24'	46'
Streaks Sand & Shale	22'	68'
Rock at 68' - 69' (Very Hard)		
Hard Sandy Shale	21'	90'
Very Hard Sandy Shale	15'	105'
Sand, Thin Strks Shale	8'	113'
Sand	89'	202'
Sand w/ Thin Strks Shale	10'	212'
Rock --- VERY HARD		212'

Information upon completion of well:

(1) Diameter 16 inches.

(2) Total Depth 213'-1" feet.

(3) Water Level 56'-6" feet below top of ground.

(4) Cased to 165', Size 16"

(5) Screen: Size 10", Length 40'-1"


(6) Were any formations sealed against pollution?

X yes, no.

If YES depth of formation Cemented Casing

Why

Drillers Remarks:

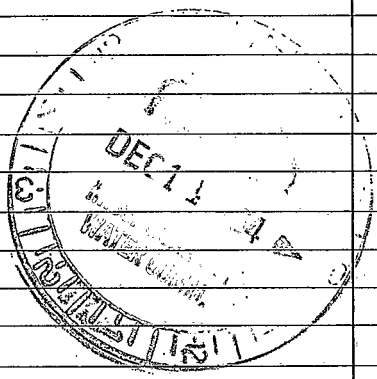

(Use Back Side)

Well No.

(1)

.....

.....

11