

MONROE  
 L 32  
 2-27-69

MISSISSIPPI  
 BOARD OF WATER COMMISSIONERS  
 416 North State Street  
 Jackson, Mississippi 39201

CODED

WATER WELL DRILLERS LOG

2-27-1969 Herndon-Homan Well & Supply, Inc. MONROE  
 date well completed firm name county well located  
 SIEMANN, MISSISSIPPI 38866

LANDOWNER:	description of formations encountered	from	to
Contractor	Surface sand	0	18
Wileman Lumber Co.	Blue clay	18	90
Aberdeen, Miss.	Sand	90	200
(mailing address)	Bottom	200	
WELL LOCATION:	CODED		
sec. 18 T. 14 N. R. 7 E			
5 S			
miles of Aberdeen			
(distance) (direction) (nearest town)			
WELL PURPOSE:			
(home, irrigation, municipal, industrial)	Home		
WELL COMPLETION DATA:			
(1) diameter (inches)	5		
(2) total depth (feet)	200		
(3) static water level (feet)	160 below top of ground		
(4) casing (material)	Steel 21' 4" (depth)		
(size)	5 if telescope see back.		
(5) screen (length)	20 (depth to top)		
(size)	5 (material)		
(6) pump (HP)	1/3 5 (yield gpm)		
(type power)	electric		
(7) electric log (yes or no)	no		
(organization running log)			
(8) how well bottom plugged	open		


APR - 5 1969

MISS. DE. GE  
 WATER COMMISSIONERS

DRILLERS REMARKS:

If well telescopes please sketch and show depths.

GROUND LEVEL

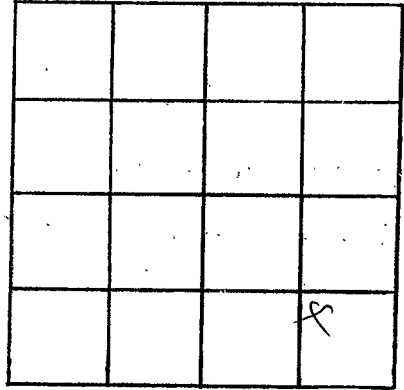

SECTION 18

Please indicate well location X.

ADDITIONAL INFORMATION

If more than one screen,  
show locations of each on sketch.