

**MONROE**  
**L-33**  
**7-20-71**

MISSISSIPPI  
 BOARD OF WATER COMMISSIONERS  
 416 North State Street  
 Jackson, Mississippi 39201

**CODED**

WATER WELL DRILLERS LOG  
 Harndon-Homan Well & Supply, Inc.

P. O. Box 42 *Monroe*

*7-20* 19 *71*  
 date well completed

*MONROE* MISSISSIPPI *13800* county well located

LANDOWNER: *Tom Lewis*  
*Route 4, Box 103 B*  
*Aberdeen, Miss 39730*  
 (mailing address)

| description of formations encountered | from       | to         |
|---------------------------------------|------------|------------|
| <i>Surface sand &amp; clay</i>        | <i>0</i>   | <i>7.5</i> |
| <i>Blue clay</i>                      | <i>7.5</i> | <i>120</i> |
| <i>Sand</i>                           | <i>120</i> | <i>260</i> |
| <i>Bottom</i>                         | <i>260</i> |            |

WELL LOCATION:  
 sec. *17* T. *14* N. R. *7* E  
*1/2* miles *SW* of *Aberdeen*  
 (distance) (direction) (nearest town)

WELL PURPOSE: *Home*  
 (home, irrigation, municipal, industrial)

- WELL COMPLETION DATA:
- (1) diameter (inches) *5"*
  - (2) total depth (feet) *260*
  - (3) static water level (feet) *68* below top of ground.
  - (4) casing *Steel*, *28 1/2"* (material) (depth)  
*5"* if telescope see back. (size)
  - (5) screen *70* (length) (depth to top)  
 (size) (material)
  - (6) pump *3/4* (HP) *10* (yield gpm)  
*electric* (type power)
  - (7) electric log *no* (yes or no)  
 (organization running log)
  - (8) how well bottom plugged *open*


**CODED**

MISSISSIPPI  
 WATER COMMISSIONERS

DRILLERS REMARKS:

If well telescopes please sketch and show depths.

GROUND LEVEL

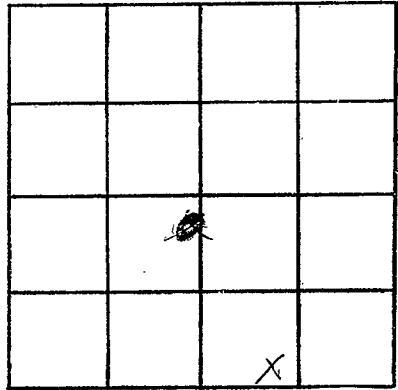

SECTION 17

Please indicate well location X.

ADDITIONAL INFORMATION

If more than one screen, show locations of each on sketch.