

Coded


MISSISSIPPI
BOARD OF WATER COMMISSIONERS
416 North State Street
Jackson, Mississippi 39201

WATER WELL DRILLERS LOG

Monroe
L 35
7-67

July 19 67 Carloss Well Supply Co Monroe
date well completed firm name county well located


LANDOWNER:	description of formations encountered	from	to
City of Aberdeen			
Aberdeen, Mississippi	White Clay	0	15
(mailing address)	Sand, Shells, Rock	15	24
	Sand, Strks, Shale	24	48
WELL LOCATION:	Hard Sandy Shale	48	85
sec. 20 T 14 N R 7 E	Hard Rock	85	86
ON AIRPORT PROPERTY	Sand	86	92
(distance) miles of (direction) of (nearest town)	Hard Rock	92	93
	Sand, Lignite, Rock	93	115
WELL PURPOSE: Municipal	Shale, Strks, Sand	115	130
(home, irrigation, municipal, industrial)	Fine Sand	130	137
WELL COMPLETION DATA:	Fine, Gummy Sand	137	160
(1) diameter (inches) 16"	Sand	160	224
(2) total depth (feet) 224'	Hard Rock	224	225
(3) static water level (feet) 76' below top of ground.	Hard Clay	225	226
(4) casing Blk Stl. 165' (material), (depth)	Sand	226	246
No/ (size) if telescope see back.	Hard Rock	246	247
(5) screen 45' 178' (length), (depth to top)	Clay	247	250
10" Stainless Steel (size), (material)			
(6) pump 40 300 (HP), (yield gpm)			
Electric (type power)			
(7) electric log No (yes or no)			
(organization running log)			
(8) how well bottom plugged B.P. Valve			
DRILLERS REMARKS:			
BETTER THAN THE LAST ONE..			

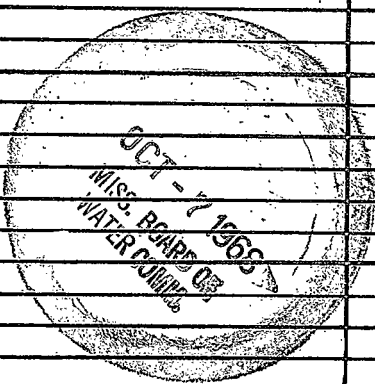

2

If well telescopes please sketch and show depths.

GROUND LEVEL

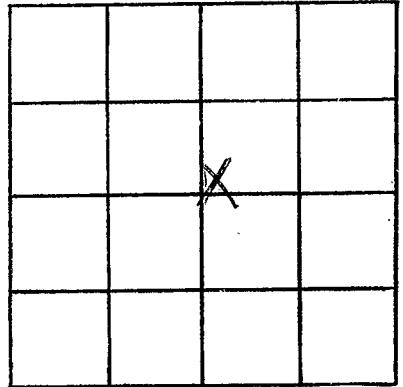

SECTION _____

Please indicate well location X.

ADDITIONAL INFORMATION

If more than one screen,
show locations of each on sketch.