

MONROE

MISSISSIPPI BOARD OF WATER COMMISSIONERS

L38

CODED

8-27-62

WATER WELL DRILLERS LOG

Date: Aug 27, 1962, Driller: HERNDON WELL & SUPPLY CO. County: Madison  
P.O. BOX 42  
SHANNON, MISSISSIPPI

(1) Owner of Land:	Description & Color of Materials Sand, Clay, Red Clay, Shell, etc.	Thick- ness Feet	Depth Feet
<u>Hugh W. Bowers</u> (Name)	<u>sand &amp; clay</u>		<u>0</u>
<u>Abbeville, Miss</u> (Address)	<u>T</u>		
(2) Location: <u>NW NW SW</u> 1/4, Sec. <u>20</u> T. <u>R7E</u>	<u>T</u>		<u>68</u>
<u>1</u> miles <u>NW</u> of <u>Abbeville</u> (distance) (direction) (Nearest Town)	<u>sand</u>		<u>100</u>
(3) Topography: <u>Flat</u> (Hilly) (Flat) (Level)	<u>T</u>		
(4) Purpose of Well: <u>Domestic</u> (Domestic Irrigation Municipal, Industrial, Other)	<u>Bottom</u>		<u>220</u>


Information upon completion of well:

- (1) Diameter 4 inches.
- (2) Total Depth 220 feet.
- (3) Water Level 90 feet below top of ground.
- (4) Cased to 72' 8", Size 4
- (5) Screen: Size —, Length —
- (6) Were any formations sealed against pollution?  
✓ yes, — no.

If YES depth of formation 68  
Why sand & gravel

Drillers Remarks:

CODED

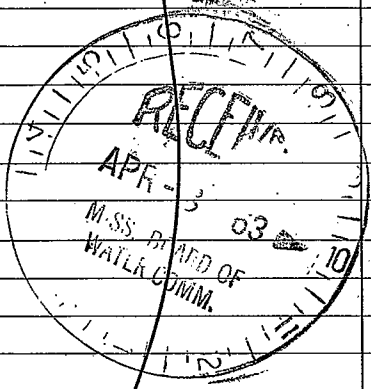

(Use Back Side)

Well No.

