

MONROE

L39

10-4-60

WATER WELL DRILLING

Herndon Well & Supply

SHANNON, MISS.

CODED 203

Date: Oct 4, 1960, Driller: _____ County Monroe

(Name)

(1) Owner of Land: H. D. Millisix
(Name)

Box 1 Aberdeen, Miss
(Address)

(2) Location: SW 5th NE 1/4, Sec. 20 4th R 7

4 miles NW, of Aberdeen
(distance) (direction) (Nearest Town)

(3) Topography: Flat
(Hilly) (Flat) (Level)

(4) Purpose of Well: Home use
(Domestic Irrigation
Municipal, Industrial, Other)

Description & Color of Materials
Sand, Clay, Red Clay, Shell, etc.

Thick-
ness
Feet

Depth
Feet

sand & clay

55

blue sand

100

sand

Bottom

210

Information upon completion of well:

(1) Diameter 4 inches.

(2) Total Depth 210 feet.

(3) Water Level 60 feet below top of ground.

(4) Cased to 62 ft Size 4 in.

(5) Screen: Size _____, Length _____

(6) Were any formations sealed against pollution?


yes yes, _____ no.

If YES depth of formation 55 ft

Why Surface & sand

Drillers Remarks: _____

CODED

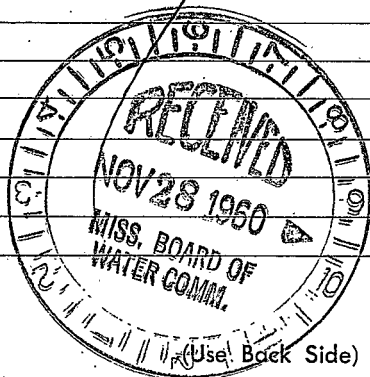

Well No.

1945

1946

1947

1948

1949

1950

1951

1952

1953