

MONROE
L40
6-66

MISSISSIPPI BOARD OF WATER COMMISSIONERS

CODED

WATER WELL DRILLERS LOG

Date: 6-23, 1966, Driller: J.C. REEVES County MONROE
(When well drilled) (Name) (Where well is located)

(1) Owner of Land: JOHN BOWEN
(Name)
HAMILTON, MISS.
(Address)
SE SENE
 (2) Location: Highway 45 N 28
1/4, 1/4, Sec. 20 T14R7,
1 miles N of ABERDEEN
(distance) (direction) (Nearest Town)
 (3) Topography: HILLY
(Hilly) (Flat) (Level)
 (4) Purpose of Well: CAR WASH
(Domestic Irrigation
Municipal, Industrial, Other)


Description & Color of Materials Sand, Clay, Red Clay, Shell, etc.	Thick- ness Feet	Depth Feet
<u>RED SAND</u>	<u>21</u>	<u>0</u>
<u>BLUE SAND</u>	<u>24</u>	<u>21</u>
<u>" CLAY</u>	<u>34</u>	<u>45</u>
<u>" SAND</u>	<u>120</u>	<u>79</u>
<u>" CLAY</u>	<u>5</u>	<u>199</u>
<u>" SAND</u>	<u>5</u>	<u>204</u>
<u>" CLAY</u>	<u>10</u>	<u>209</u>
<u>" SAND</u>	<u>3</u>	<u>219</u>
<u>" CLAY</u>	<u>6</u>	<u>222</u>
<u>" SAND</u>	<u>3</u>	<u>228</u>
<u>" CLAY</u>	<u>4</u>	<u>231</u>
<u>" SAND</u>	<u>50</u>	<u>235</u>

Information upon completion of well:

(1) Diameter 4 inches.
 (2) Total Depth 285 feet.
 (3) Water Level 75 feet below top of ground.
 (4) Cased to 84', Size 4"
 (5) Screen: Size none, Length _____
 (6) Were any formations sealed against pollution?
 _____ yes, _____ no.

CODED

If YES depth of formation _____
 Why _____
 Drillers Remarks: _____
 Yield in gpm: 75
 Size pump: 1 1/2 H.P. SUB. - 500 GPM
 Type power: ELECTRIC

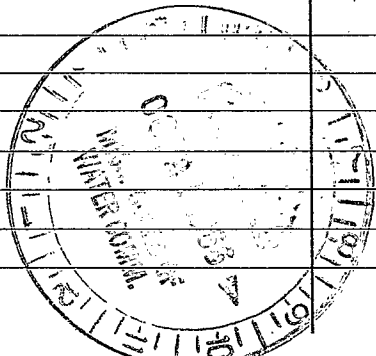

[The page contains extremely faint and illegible text, likely bleed-through from the reverse side of the document. No specific content can be transcribed.]