

MONROE

MISSISSIPPI BOARD OF WATER COMMISSIONERS

LAI

WATER WELL DRILLERS LOG

Herndon Well & Supply Co.

SHANNON, MISS.

CODED

12-30-60

Date: 12/30, 1960, Driller:

(Name)

County Monroe

(1) Owner of Land: Loyd Gayton (Name)

Abbeville, Miss (Address)

(2) Location: NW SE 1/4, NE 1/4, Sec 20 T. 14 S. R. 7 E

0 miles N S of Abbeville (distance) (direction) (Nearest Town)

(3) Topography: Flat (Hilly) (Flat) (Level)

(4) Purpose of Well: Home use (Domestic Irrigation Municipal, Industrial, Other)

Description & Color of Materials Sand, Clay, Red Clay, Shell, etc.

Thick-ness Feet

Depth Feet

Sand & clay Blue Rock

50

Sand & clay

100

Bottom

210

Information upon completion of well:

(1) Diameter 4 inches.

(2) Total Depth 210 feet.

(3) Water Level 50 feet below top of ground.

(4) Cased to 59' 7", Size 4"

(5) Screen: Size _____, Length _____

(6) Were any formations sealed against pollution?


yes, no.

If YES depth of formation 50

Why SAND & surface

Drillers Remarks:

CODED

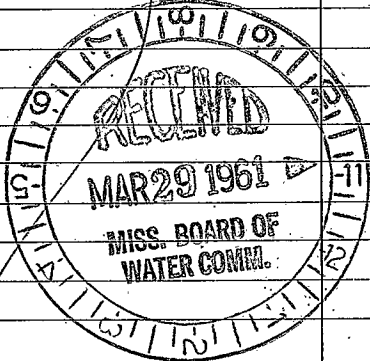

(Use Back Side)

Well No.

1. Introduction

2. Methodology

3. Results

4. Discussion

5. Conclusion

6. References

7. Appendix

8. Acknowledgements

9. Contact Information

10. Author Biographies

11. Declaration of Interest

12. Funding Sources

13. Data Availability

14. Ethics Approval

15. Supplementary Materials

16. Correspondence

17. Peer Review

18. Publication History

19. Copyright

20. Disclaimer

21. Terms and Conditions

22. Privacy Policy

23. About Us

24. Contact Us

25. Sitemap