

MONROE
E42
10-66

MISSISSIPPI BOARD OF WATER COMMISSIONERS

WATER WELL DRILLERS LOG

CODED

Stanton-Homan Well & Supply, Inc.

Date: Oct 16, 1966, Driller: F. O. Box 42 County Monroe
(When well drilled) TRAILER (Name) SEANOR, MISSISSIPPI STATE (Where well is located)



(1) Owner of Land: Faellie Crabbs
(Name)
At 3 Aberdeen
SE SW SW (Address)
(2) Location: SW 1/4, SW 1/4, Sec. 17, T4S, R7E
1 miles NW, of Aberdeen
(distance) (direction) (Nearest Town)
(3) Topography: flat
(Hilly) (Flat) (Level)
(4) Purpose of Well: Home
(Domestic Irrigation
Municipal, Industrial, Other)

Description & Color of Materials Sand, Clay, Red Clay, Shell, etc.	Thick- ness Feet	Depth Feet
<u>surface sand & clay</u>	<u>0</u>	<u>35</u>
<u>blue clay</u>	<u>35</u>	<u>100</u>
<u>sand</u>	<u>100</u>	<u>220</u>
<u>bottom</u>	<u>220</u>	

Information upon completion of well:

(1) Diameter 4 inches.
(2) Total Depth 220 feet.
(3) Water Level 80 feet below top of ground.
(4) Cased to 39'7", Size 4"
(5) Screen: Size NONE, Length _____
(6) Were any formations sealed against pollution?
Yes, _____ no.

If YES depth of formation 35'
Why surface & sand
Drillers Remarks: _____
Yield in gpm: by other
Size pump: _____
Type power: _____

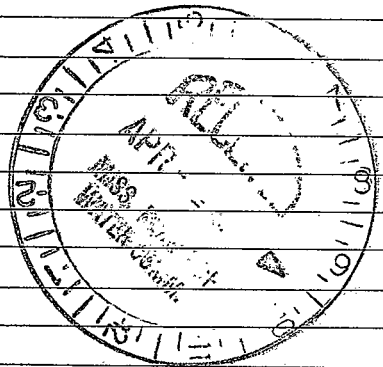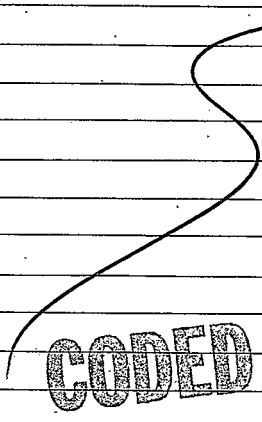

The first part of the document discusses the importance of maintaining accurate records of all transactions. It emphasizes that every entry should be supported by a valid receipt or invoice. This ensures transparency and allows for easy verification of the data.

In the second section, the author details the various methods used to collect and analyze the data. This includes both primary and secondary sources, as well as the specific techniques employed for data processing and statistical analysis.

The third section provides a comprehensive overview of the results obtained from the study. It highlights the key findings and discusses their implications for the field. The author also addresses any limitations of the study and suggests areas for future research.

Finally, the document concludes with a summary of the main points and a final statement on the significance of the work. The author expresses their gratitude to the funding agencies and the research team for their support and contributions.