

MONROE  
 4300  
 12-1768

MISSISSIPPI  
 BOARD OF WATER COMMISSIONERS  
 416 North State Street  
 Jackson, Mississippi 39201

CODED  
 CODED  
 CODED

WATER WELL DRILLERS LOG

12-17 1968 W. J. REEVES & SON MONROE  
 date well completed firm name county well located

LANDOWNER: PETE SANDLIN

description of formations encountered

from

to

Hiway 45 So.

ABERDEEN, MISS -  
 (mailing address)

SANDY CLAY  
 SAND & GRAVEL  
 BLUE CLAY

0 12  
 12 30  
 30 31 1/2

WELL LOCATION:

sec. 25 T. 14 S. R. 19 E. W. 19 W  
 3 miles SE of ABERDEEN  
 (distance) (direction) (nearest town)

WELL PURPOSE: HOME  
 (home, irrigation, municipal, industrial)

WELL COMPLETION DATA:

- (1) diameter (inches) 4
- (2) total depth (feet) 31 1/2
- (3) static water level (feet) 10 below top of ground
- (4) casing PVC 31 1/2 (material) (depth)  
 4 (size) if telescope see back.
- (5) screen 4" 26' (length) (depth to top)  
 4" PVC (size) (material)
- (6) pump 1/2 8 (HP) (yield gpm)
- ELECT (type power)
- (7) electric log NO (yes or no)

CODED

(organization running log)

(8) how well bottom plugged SAND


JAN 10 1969

DRILLERS REMARKS

MISS. Bd. OF  
 WATER COMM.

If well telescopes please sketch and show depths.

GROUND LEVEL

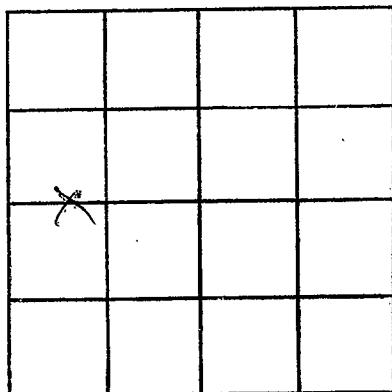

SECTION 25

Please indicate well location X.

ADDITIONAL INFORMATION

If more than one screen, show locations of each on sketch.