

MONROE  
L44  
5-65

MISSISSIPPI BOARD OF WATER COMMISSIONERS

CODED

WATER WELL DRILLERS LOG

Date: May 12, 1965, Driller: Herndon-Homan Well & Supply, Inc.  
P. O. Box 42 County Marion  
SHANNON, MISSISSIPPI 38868

(1) Owner of Land: C.E. Bobby Healey  
(Name)  
Abbeville, Miss.  
SW NW (Address)  
(2) Location: SE 1/4, SE 1/4, Sec 30 T 14 S R 7 E  
7 miles W of Abbeville  
(distance) (direction) (Nearest Town)  
(3) Topography: FLAT  
(Hilly) (Flat) (Level)  
(4) Purpose of Well: DOMESTIC  
(Domestic Irrigation  
Municipal, Industrial, Other)


Description & Color of Materials Sand, Clay, Red Clay, Shell, etc.	Thick- ness Feet	Depth Feet
<u>surface sand</u>		
<u>&amp; clay</u>	<u>0</u>	<u>18</u>
<u>blue clay</u>	<u>18</u>	<u>50</u>
<u>sand &amp; clay</u>	<u>50</u>	<u>180</u>
<u>sand</u>	<u>180</u>	<u>300</u>
<u>bottom</u>	<u>300</u>	

Information upon completion of well:

(1) Diameter 5 inches.  
(2) Total Depth 300 feet.  
(3) Water Level 60 feet below top of ground.  
(4) Cased to 21', Size 5"  
(5) Screen: Size —, Length —  
(6) Were any formations sealed against pollution?  
 yes,  no.

If YES depth of formation 18'  
Why surface & sand  
Drillers Remarks:

CODED

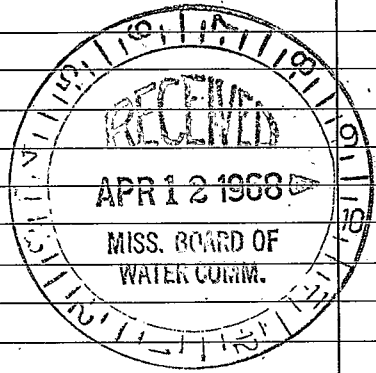

(Use Back Side)

Well No.

