

MONROE
L45
10-67

MISSISSIPPI
BOARD OF WATER COMMISSIONERS
416 North State Street
Jackson, Mississippi 39201
WATER WELL DRILLERS LOG

CODED

10/19 1967 Herndon-Roman Well & Supply, Inc. Monroe
date well completed P.M. Ord. No. 42 county well located

LANDOWNER:

Felix Cantrell

Hwy 8 W. 3692489

Abeudeed, Miss.
(mailing address)

WELL LOCATION:

20³³ sec. 23 T. 14^N R. 7^E S. 1
1 miles W of Abeudeed
(distance) (direction) (nearest town)

WELL PURPOSE: Home
(home, irrigation, municipal, industrial)

WELL COMPLETION DATA:


- (1) diameter (inches) 4"
- (2) total depth (feet) 240'
- (3) static water level (feet) 65' below top of ground.
- (4) casing steel, 104' (material) (depth)
if telescope see back.
- (5) screen none (length) (depth to top)
(size) (material)
- (6) pump 1/3 (HP) 5 (yield gpm)
electric (type power)
- (7) electric log no (yes or no)
(organization running log)
- (8) how well bottom plugged open

description of formations encountered

from to

surface sand		
clay	0	100
Blue clay	100	120
sand	120	240
bottom	240	

CODED

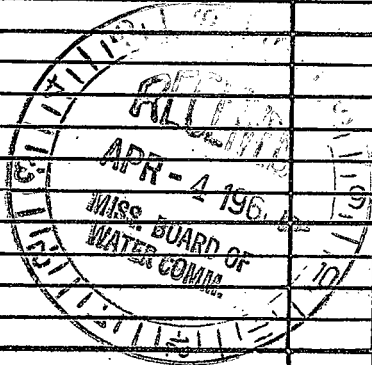

DRILLERS REMARKS:

If well telescopes please sketch and show depths.

GROUND LEVEL

	ⓧ		
	X		

20

SECTION



Please indicate well location X.

ADDITIONAL INFORMATION

If more than one screen, show locations of each on sketch.