

MONROE

L 47

6-17-61

WATER WELL DRILLERS LOG

HERNDON WELL & SUPPLY CO.

Date: June 17, 1961, Driller: P. O. BOX 42 County Monroe

SHANNON, MISSISSIPPI

CODED

L305

3rd Br H& 22 R4.

CHANGED

(1) Owner of Land: Ewe Murphy (Name)

Rt 3 Aberdeen Miss Hwy 45 N. 3698429 (Address)

(2) Location: SE 1/4, NE 1/4, Sec. 20 T145 R27

4 miles North of Aberdeen (distance) (direction) (Nearest Town)

(3) Topography: Flat (Hilly) (Flat) (Level)

(4) Purpose of Well: Domestic (Domestic Irrigation Municipal, Industrial, Other)

Description & Color of Materials Sand, Clay, Red Clay, Shell, etc.

Thick-ness Feet

Depth Feet

Surface sand & clay

0

Blue rock

60

Sand

100

Bottom

220

Information upon completion of well:

(1) Diameter 4 inches.

(2) Total Depth 220 feet.

(3) Water Level 25 feet below top of ground.

(4) Cased to 65' 8", Size 4"

(5) Screen: Size _____, Length _____

(6) Were any formations sealed against pollution?


yes, no.

If YES depth of formation 60

Why Surface & sand

Drillers Remarks:

CODED

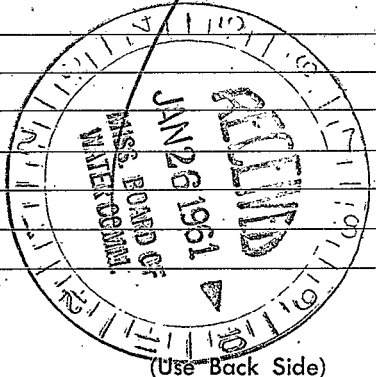

(Use Back Side)

Well No.

