

L48

12-27-60

WATER WELL DRILLERS LOG

2  
CODED

Date: 12-27, 1960, Driller: W. J. REEVES <sup>SON</sup> County MONROE

277-2  
(Name)

(1) Owner of Land: FELIX TUBB  
(Name)  
ABERDEEN, MISS  
COUNTY RD. 3692310 (Address)

(2) Location: NE 1/4, NW 1/4, Sec. 15 T4R7,  
5 miles N, of ABERDEEN  
(distance) (direction) (Nearest Town)

(3) Topography: HILLY  
(Hilly) (Flat) (Level)

(4) Purpose of Well: DOMESTIC  
(Domestic Irrigation  
Municipal, Industrial, Other)

Description & Color of Materials Sand, Clay, Red Clay, Shell, etc.	Thick- ness Feet	Depth Feet
<u>RED SAND</u>	<u>17</u>	<u>0</u>
<u>BLUE CLAY</u>	<u>58</u>	<u>17</u>
<u>BLUE SAND - CLAY SPARS</u>	<u>50</u>	<u>75</u>

Information upon completion of well:

(1) Diameter 4 inches.

(2) Total Depth 156 feet.

(3) Water Level 60 feet below top of ground.

(4) Cased to 22, Size 4

(5) Screen: Size \_\_\_\_\_, Length \_\_\_\_\_


(6) Were any formations sealed against pollution?  
 yes,  no.

If YES depth of formation \_\_\_\_\_

Why \_\_\_\_\_

Drillers Remarks: \_\_\_\_\_

CODED

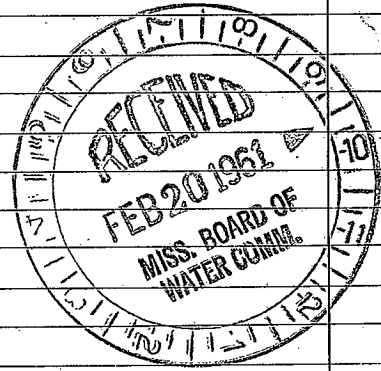

(Use Back Side)

Well No.

