

L 49

WATER WELL DRILLERS LOG

CODED

12-26-60

Date: 12-26, 1960, Driller: W. J. REEVES, Som County, MONROE

268-1 1337-12 NOT IN USE - ON W.S. (Name)

(1) Owner of Land: JOHN BETHAY (Name)

ABERDEEN, Miss (Address) MEADOW LN 369 8444

(2) Location: NE 1/4, SW 1/4, Sec. 5 T14R7,

6 miles N, of ABERDEEN (distance) (direction) (Nearest Town)

(3) Topography: FLAT (Hilly) (Flat) (Level)

(4) Purpose of Well: DOMESTIC (Domestic Irrigation Municipal, Industrial, Other)

Information upon completion of well:

(1) Diameter 4 inches.

(2) Total Depth 110 feet. 25.65 3-3-72

(3) Water Level 26 feet below top of ground.

(4) Cased to 23', Size 4"

(5) Screen: Size _____, Length _____.

(6) Were any formations sealed against pollution? _____ yes, _____ no.


If YES depth of formation _____.

Why _____.

Drillers Remarks: _____.

Description & Color of Materials Sand, Clay, Red Clay, Shell, etc.	Thick- ness Feet	Depth Feet
CLAY	19	0
BLUE CLAY	22	19
" SAND	11	31
" CLAY	27	52
" SAND	31	79

CODED

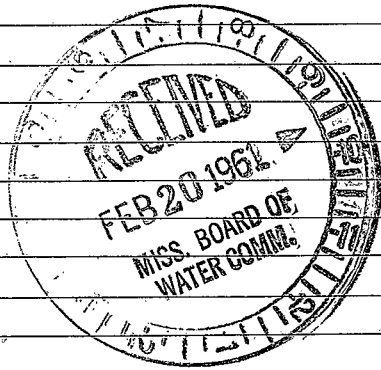

(Use Back Side)

Well No.

$$\begin{array}{r} 40 \\ -14.35 \\ \hline 25.65 \end{array}$$