

MONROE MISSISSIPPI BOARD OF WATER COMMISSIONERS

L50

2-15-65

WATER WELL DRILLERS LOG

**CODED**

Herndon-Homan Well & Supply, Inc.

Date: Feb. 15, 1965, Driller: SHANNON, MISSISSIPPI 38868 P. O. Box 42 County Monroe

ONEAL B. POUNDERS (Name)

(1) Owner of Land: Robert Dask  
(Name)

St. 1 Aberdeen Miss  
(Address)

(2) Location: NW 1/4, SE NW 1/4, Sec. 10 T. 14 N. R. 7 E

4 miles N of Aberdeen  
(distance) (direction) (Nearest Town)

(3) Topography: Flat  
(Hilly) (Flat) (Level)

(4) Purpose of Well: Domestic  
(Domestic Irrigation  
Municipal, Industrial, Other)

Description & Color of Materials Sand, Clay, Red Clay, Shell, etc.	Thick- ness Feet	Depth Feet
<u>Surface sand &amp; clay</u>		<u>0-18</u>
<u>Blue clay</u>		<u>18-68</u>
<u>0 sand</u>		
<u>Blue clay</u>		<u>68-80</u>
<u>sand</u>		<u>80-160</u>
<u>Bottom</u>		<u>160</u>

Information upon completion of well:

(1) Diameter 4 inches.

(2) Total Depth 160 feet.

(3) Water Level 60 feet below top of ground.

(4) Cased to 70' 2", Size 4"

(5) Screen: Size —, Length —

(6) Were any formations sealed against pollution?


yes,  no.

If YES depth of formation 68'

Why surface & sand

Drillers Remarks:

**CODED**

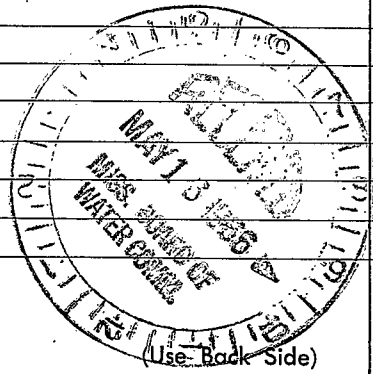

Retain this copy for your office files.

Well No.

1900

1900

