

L51

3-21-62

WATER WELL DRILLERS LOG
HERNDON WELL & SUPPLY CO.

CODED

Date: March 21, 1962, Driller: SHANNON P.O. BOX 42
MISSISSIPPI County MONROE
(Name)

(1) Owner of Land: Leslie Williams
(Name)

Rt 3 Aberdeen, Miss
(Address)

Hwy 8 W 3694826
(2) Location: SW SW 20 145
1/4, 1/4, Sec 20 T R 7E

1 miles NW, of Aberdeen
(distance) (direction) (Nearest Town)

(3) Topography: Flat
(Hilly) (Flat) (Level)

(4) Purpose of Well: Domestic
(Domestic Irrigation
Municipal, Industrial, Other)

Description & Color of Materials Sand, Clay, Red Clay, Shell, etc.	Thick- ness Feet	Depth Feet
<u>Surface sand</u>		<u>0</u>
<u>& clay</u>		
<u>Thin zone</u>		<u>75</u>
<u>Sand</u>		<u>110</u>
<u>to</u>		
<u>Bottom</u>		<u>230</u>

Information upon completion of well:

(1) Diameter 4 inches.

(2) Total Depth 230 feet.

(3) Water Level 80 feet below top of ground.

(4) Cased to 81 ft, Size 4"

(5) Screen: Size —, Length —


(6) Were any formations sealed against pollution?
— yes, — no.

If YES depth of formation 75 ft.
Surface sand.

Why —

Drillers Remarks: —

CODED

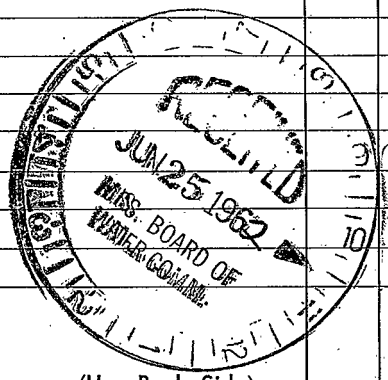

(Use Back Side)

Well No.

[The page contains extremely faint and illegible text, likely bleed-through from the reverse side of the document. No specific words or phrases can be discerned.]