

MONROE

WATER WELL DRILLERS LOG

L 53

Herndon Well & Supply Co.

CODED

L300

8-29-60

SHANNON, MISS.

County Monroe

Date: Aug 29, 1960, Driller:

(Name)

OUT 45N PAST A.P. PAS BR - TAKE RT. AT NEW BR HOUSE - 1ST Bldg ON LEFT

(1) Owner of Land: James Fields

(Name)

Description & Color of Materials
Sand, Clay, Red Clay, Shell, etc.

Thick-
ness
Feet

Depth
Feet

SAND

Abbeville Miss.

HW 45N, 3694496 (Address)

(2) Location: E 1/2 SW 1/4, Sec. 5 24R7

Blue Clay

5 miles North W of Abbeville (distance) (direction) (Nearest Town)

SAND

(3) Topography: Flat

(Hilly) (Flat) (Level)

Bottom

(4) Purpose of Well: Home Use

(Domestic Irrigation, Municipal, Industrial, Other)

Information upon completion of well:

(1) Diameter 4 inches.

(2) Total Depth 200 feet.

(3) Water Level 60 feet below top of ground.

(4) Cased to 84 ft, Size 4"

(5) Screen: Size —, Length —

(6) Were any formations sealed against pollution?


X yes, no.

If YES, depth of formation 84 ft

Why Surface of Sand

Drillers Remarks:

CODED

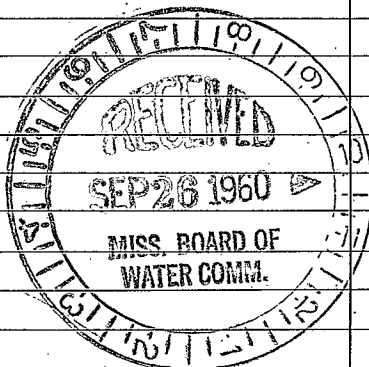

(Use Back Side)

Well No. L300

