

L57

7-18-60

WATER WELL DRILLERS LOG

CODED

L 301

Date: 7-18, 19 60, Driller: W. J. REEVES & SON County MONROE

TURN T ROAD DETT ACROSS FROM RYDER TRUCK RE BT HO1

(1) Owner of Land: WILKINSON AGR. CO. - BOWEN

(Name)

Highway US V. ABERDEEN

(Address)

(2) Location: NENESE 1/4, 1/4, Sec. 20 T4S R7E

2 miles NORTH of ABERDEEN (distance) (direction) (Nearest Town)

(3) Topography: LEVEL (Hilly) (Flat) (Level)

(4) Purpose of Well: DOMESTIC (Domestic Irrigation Municipal, Industrial, Other)

Description & Color of Materials Sand, Clay, Red Clay, Shell, etc.

Thick-ness Feet

Depth Feet

|           |    |     |
|-----------|----|-----|
| CLAY      | 16 | 0   |
| RED SAND  | 8  | 16  |
| BLUE CLAY | 12 | 28  |
| BLUE SAND | 8  | 36  |
| BLUE CLAY | 70 | 106 |
| BLUE SAND | 86 | 192 |

Information upon completion of well:

(1) Diameter: 4 inches.

(2) Total Depth: 200 feet.

(3) Water Level: 60 feet below top of ground.

(4) Cased to 47' 9", Size 4"

(5) Screen: Size \_\_\_\_\_, Length \_\_\_\_\_


(6) Were any formations sealed against pollution? \_\_\_\_\_ yes, \_\_\_\_\_ no.

If YES depth of formation \_\_\_\_\_

Why \_\_\_\_\_

Drillers Remarks: \_\_\_\_\_

CODED

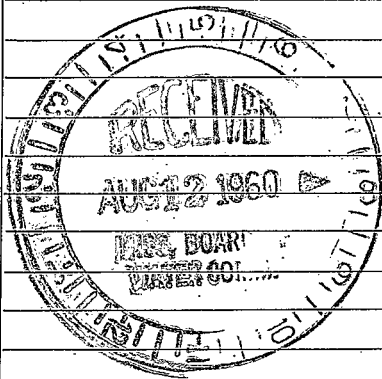

(Use Back Side)

Well No L501

