

MONROE
 L 69
 5-4-73

MISSISSIPPI
 BOARD OF WATER COMMISSIONERS
 416 North State Street
 Jackson, Mississippi 39201

CODED

WATER WELL DRILLERS LOG

May 4 1973 J.W. Webb & Sons Monroe
 date well completed firm name county well located

LANDOWNER: Metric Bruff
Rt 2 Box 526
Aberdeen
 (mailing address)

description of formations encountered	from	to
	<u>loam soil</u>	<u>0</u>
<u>sand & gravel</u>	<u>3</u>	<u>60</u>

WELL LOCATION:
 sec. 22 T. 14 N. R. 19 W.
1 miles E of Aberdeen
 (distance) (direction) (nearest town)

WELL PURPOSE: home
 (home, irrigation, municipal, industrial)

- WELL COMPLETION DATA:
- diameter (inches) 4 1/2"
 - total depth (feet) 60 ft
 - static water level (feet) 12 below above top of ground.
 - casing plastic, 60 ft
 (material) (depth)
4 1/2" if telescope see back.
 (size)
 - screen _____
 (length) (depth to top)

 (size) (material)
 - pump _____
 (HP) (yield gpm)

 (type power)
 - electric log NO
 (yes or no)

 (organization running log)
 - how well bottom plugged cased to bottom

CODED


JUN 12 1973
 CIR2

DRILLERS REMARKS:

MISSISSIPPI
 BOARD OF WATER COMMISSIONERS
 JACKSON, MISSISSIPPI

If well telescopes please sketch and show depths.

GROUND LEVEL

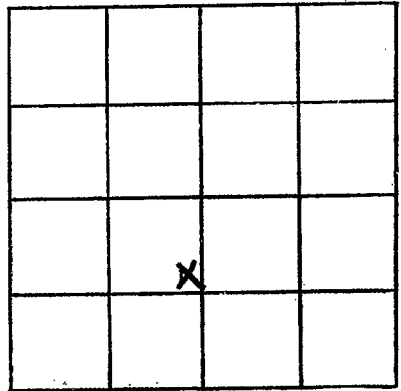

SECTION 22

Please indicate well location X.

ADDITIONAL INFORMATION

If more than one screen,
show locations of each on sketch.