

MONROE  
L 70  
4-4-73

MISSISSIPPI  
BOARD OF WATER COMMISSIONERS  
416 North State Street  
Jackson, Mississippi 39201  
WATER WELL DRILLERS LOG

**CODED**

April 4 1973 J.W. Webb & Sons MONROE  
date well completed firm name county well located

LANDOWNER: Kirby C. Howarth	description of formations encountered	from	to
Abbeedeen, Miss. (mailing address)	top soil sand & gravel blue marl light to dark blue sand	0 4 70 90	4 70 90 240
<p>WELL LOCATION: sec 35 T 14 N R 19 W 1/2 mile south of Abbeedeen (distance) (direction) (nearest town)</p>			
<p>WELL PURPOSE: home (home, irrigation, municipal, industrial)</p>			
<p>WELL COMPLETION DATA:</p>			
<p>(1) diameter (inches) 4"</p>			
<p>(2) total depth (feet) 240 ft</p>			
<p>(3) static water level (feet) 20 below top of ground.</p>			
<p>(4) casing steel, 84 ft (material) (depth) 4" (size) if telescope see back.</p>			
<p>(5) screen (length) (depth to top) (size) (material)</p>			
<p>(6) pump Elect 6 (HP) (yield gpm) elect (type power)</p>			
<p>(7) electric log no (yes or no)</p>			
<p>(organization running log)</p>			
<p>(8) how well bottom plugged open hole</p>			
<p>DRILLERS REMARKS:</p>			


**CODED**

JUN 12 1973

MISS. DEPT. OF WATER CONTROL

If well telescopes please sketch and show depths.

GROUND LEVEL

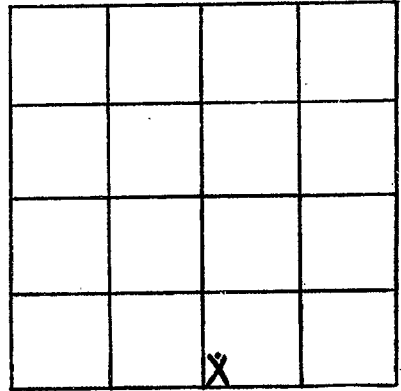

SECTION 35

Please indicate well location X.

ADDITIONAL INFORMATION

If more than one screen,  
show locations of each on sketch.