

MONROE

L 41 71

7-5-73

MISSISSIPPI BOARD OF WATER COMMISSIONERS
416 North State Street
Jackson, Mississippi 39201

CODED

WATER WELL DRILLERS LOG

7-5 1973 B. H. J. REEVEYSON MONROE
date well completed firm name county well located

LANDOWNER: JAMES LAW

description of formations encountered

from to

RT 2

ABERDEEN
(mailing address)

CLAY 0 24
WHITE SD 24 38
BLUE CLAY 38 40

WELL LOCATION:

sec. 14 T. 14 N. R. 19 E
S W
3 miles NE of ABERDEEN
(distance) (direction) (nearest town)

WELL PURPOSE: HOME
(home, irrigation, municipal, industrial)

WELL COMPLETION DATA:

- (1) diameter (inches) 4
- (2) total depth (feet) 40
- (3) static water level (feet) 2 below top of ground. above
- (4) casing PVC, 28 (material), (depth)
4 (size) if telescope see back.
- (5) screen 12, 28 (length), (depth to top)
4, PVC (size), (material)
- (6) pump (HP) (yield gpm)
(type power)
- (7) electric log NO (yes or no)
(organization running log)
- (8) how well bottom plugged WOOD


CODED

DRILLERS REMARKS:

MAY 20 1973
MISS. Bd. OF WATER COMMISSIONERS

If well telescopes please sketch and show depths.

GROUND LEVEL

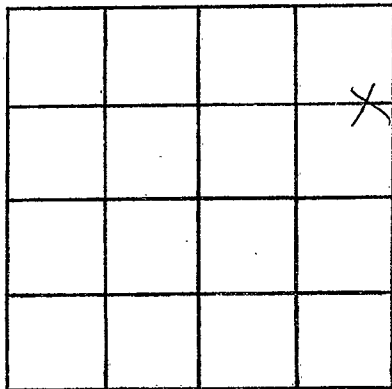

SECTION 24

Please indicate well location X.

ADDITIONAL INFORMATION

If more than one screen,
show locations of each on sketch.