

MONROE  
L 78  
5-31-77

MISSISSIPPI  
BOARD OF WATER COMMISSIONERS  
416 North State Street  
Jackson, Mississippi 39201

CODED

WATER WELL DRILLERS LOG

5-31-77 19 GRANITE CONST CO MONROE  
date well completed firm name county well located

LANDOWNER:	description of formations encountered	from	to
U.S. COOP OF ENGINEERS	CLAY & SAND FORMATIONS	174	170
(mailing address)	EUTAW	170	60
WELL LOCATION:	HIGHLY CONSOLIDATED		
sec. 22 T 14 N R 19 E	CLAY & SAND		
1/2 miles SE of ABERDEEN			
(distance) (direction) (nearest town)			
WELL PURPOSE: DEWATERING			
(home, irrigation, municipal, industrial)			
WELL COMPLETION DATA:			
(1) diameter (inches) 16			
(2) total depth (feet) 130			
(3) static water level (feet) 10 below top of ground.			
(4) casing PVC 50' (material) (depth)			
6" (size) if telescope see back.			
(5) screen 80' 50' (length) (depth to top)			
6" (size) PVC SCSBO (material)			
(6) pump 5 (HP) 110 (yield gpm)			
ELECT (type power)			
(7) electric log NO (yes or no)			
(organization running log)			
(8) how well bottom plugged PVC CAP			

CODED

RECEIVED  
JUN 9 1977


DRILLERS REMARKS:  
DRILLED 22 EA. IN APPROX. SAME LOCAT. ABERDEEN LOCK + DAM

MISS. BD. OF WATER COMM

②

If well telescopes please  
sketch and show depths.

GROUND LEVEL

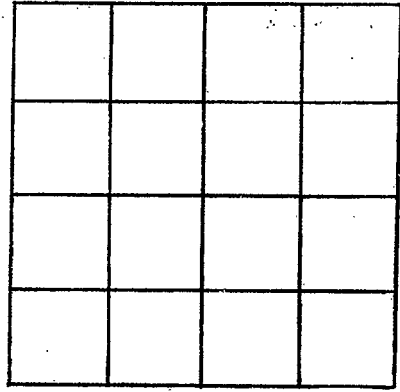

SECTION \_\_\_\_\_

Please indicate well location X.

ADDITIONAL INFORMATION

A series of horizontal lines for recording additional information, starting below the 'ADDITIONAL INFORMATION' header and extending to the bottom of the page.

If more than one screen,  
show locations of each on sketch.