

Monroe
 L 80
 11/20/77

MISSISSIPPI
 BOARD OF WATER COMMISSIONERS
 416 North State Street
 Jackson, Mississippi 39201

CODED

WATER WELL DRILLERS LOG

11/20/77 19 Greiner Drilling Service Monroe Co. Ms.
 date well completed firm name county well located

LANDOWNER: Louisiana Land & Exploration Co.
Dr L.R. Marphree Jr.
 (mailing address)

description of formations encountered

from

to

Hard Clay	0	21
Hard clay	22	42
Clay with a couple Sand breaks	43	63
Stratified Sand Clay and few roots	64	360

WELL LOCATION:
 sec. 19 T. 14 N. R. 7 E. W. 1
 500' N + 1500' E of SW/cor
 (distance) miles (direction) of Gibson
 (nearest town)

WELL PURPOSE:
 (home, irrigation, municipal, industrial)

CODED

WELL COMPLETION DATA:

- (1) diameter (inches) 3"
 (2) total depth (feet) 361'
 (3) static water level (feet) 70 below above top of ground.
 (4) casing Steel 218
 (material) (depth)

_____ If telescope see back.
 (size)

- (5) screen NA NA
 (length) (depth to top)

NA NA
 (size) (material)

- (6) pump 65
 (HP) (yield gpm)

AC
 (type power)

- (7) electric log NA
 (yes or no)

_____ (organization running log)

- (8) how well bottom plugged open
End well


DRILLERS REMARKS:

RECEIVED
 DEC 5 1977

MISS. BO. OF WATER COMMISSIONERS

If well telescopes please sketch and show depths.

GROUND LEVEL

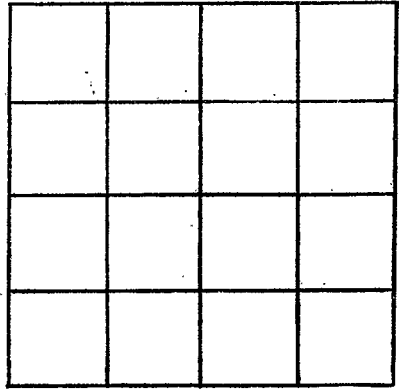

SECTION _____

Please indicate well location X.

ADDITIONAL INFORMATION

If more than one screen, show locations of each on sketch.