

MONROE  
L 81  
11/2/77

MISSISSIPPI  
BOARD OF WATER COMMISSIONERS  
416 North State Street  
Jackson, Mississippi 39201

COPIED

WATER WELL DRILLERS LOG

11/2/77 19 Given Drilling Service Monroe Co.  
date well completed firm name county well located

LANDOWNER: Louisiana Land  
Exploration  
#1 Margaret Hartwell Watkins, Mar...  
(mailing address)

description of formations encountered	from	to
Hard Clay	0	231
Stratified	231	294
Hard Clay w/lt. Capls feet of sand	294	504

WELL LOCATION:  
sec 30 T 14 N R 7 E  
10535 + 1085 E of S NW/4 Cor W  
2 miles West of Aberdeen  
(distance) (direction) (nearest town)

WELL PURPOSE:  
(home, irrigation, municipal, industrial)

- WELL COMPLETION DATA:
- (1) diameter (inches) 3"
  - (2) total depth (feet) 504
  - (3) static water level (feet) 110 below top of ground.
  - (4) casing Steel, 230' (material) (depth)  
3" (size) If telescope see back.
  - (5) screen 42' 1.52' (length) (depth to top)  
3" Perforated Pipe (size) (material)
  - (6) pump 55 (HP) (yield gpm)  
AC (type power)
  - (7) electric log NO (yes or no)  
(organization running log)
  - (8) how well bottom plugged Orange  
Peel

DRILLERS REMARKS:  
Sand


DESERVED

FEB 10 1978

MISS. BD. OF WATER COMMISSIONERS

If well telescopes please sketch and show depths.

GROUND LEVEL

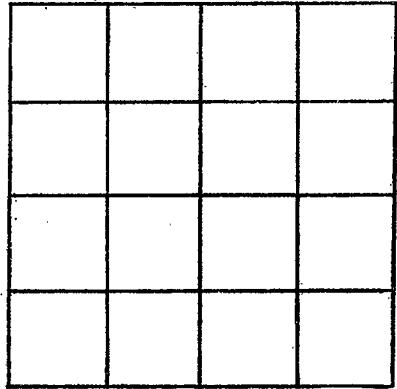

SECTION \_\_\_\_\_

Please indicate well location X.

ADDITIONAL INFORMATION

If more than one screen,  
show locations of each on sketch.