

MISSISSIPPI DEPARTMENT OF NATURAL RESOURCES

Bureau of Land and Water Resources

Southport Mall

P.O. Box 10631

Jackson, Mississippi 39209

WATER WELL DRILLERS LOG

CODED

Monroe
L83
9/4/83

SV
Hessner

TOM GRIFFITH

Monroe

9-4 19 83
date well completed

PLUMBING & WELL SERVICE, INC
Highway 320 MAYSON AVE.
COLUMBIA, MS. 39429

County well located

LANDOWNER: Pruet Production
1515 Capital Towers
Jackson, MS. 39201
(mailing address)

description of formations encountered	from	to
Chalk	0'	18'
Sand	18'	45'
Limestone	45'	130'
Sand	130'	150'
Limestone	150'	160'
Sand	160'	165'
Stratified Sand & Limestone	165'	190'
Rock	190'	191'
Stratified Sand	191'	200'
Sand	200'	250'

WELL LOCATION:
sec. 32 T 14 N R 7 E
4 1/2 miles W of Aberdeen
(distance) (direction) (nearest town)

WELL PURPOSE: Oilfield
(home, irrigation, municipal, industrial)

WELL COMPLETION DATA:

- (1) diameter (inches) 4"
- (2) total depth (feet) 250'
- (3) static water level (feet) 75' below top of ground.
- (4) casing PVC, 200', (material) (depth)
N/A If telescope see back.
- (5) screen 50', 200' (length) (depth to top)
4" PVC (size) (material)
- (6) pump air lift 5 (HP) (yield gpm)
Diesel (type power)
- (7) electric log N/A (yes or no)
N/A (organization running log)
- (8) how well bottom plugged welded

Pruett - Baria +
Mason - Minded #1
~~160' - 190' W~~
~~if Minded~~
1350'S + 160' E
if NW/100

DEPT. OF NATURAL RESOURCES
BUREAU OF LAND & WATER RESOURCES


MAY - 8 1984

RECEIVED

DRILLERS REMARKS:

If well telescopes please sketch and show depths.

GROUND LEVEL

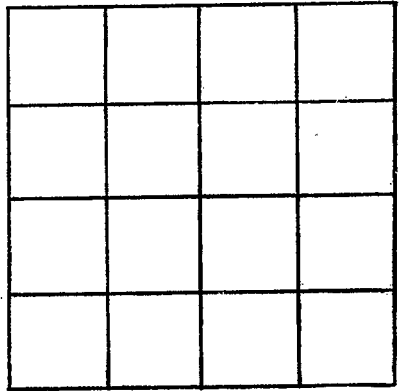

SECTION _____

Please indicate well location X.

ADDITIONAL INFORMATION

If more than one screen,
show locations of each on sketch.