


Monroe Co

L104

If well telescopes, please sketch and show depths.

GROUND LEVEL

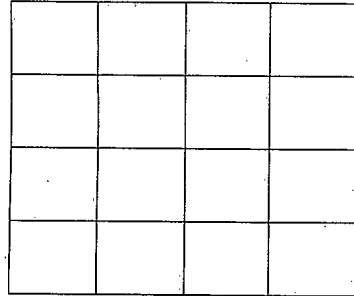

SECTION _____

Please indicate well location X.

ADDITIONAL INFORMATION

Clay, Fine Sand 254 - 257
Clay, Fine Sand, Lignite 257 - 272
Clay, Fine Sand 272 - 275

RECEIVED

AUG 09 2001

Dept. of Environmental Quality
Office of Land & Water Resources

If more than one screen,
show location of each on sketch.

