

MISSISSIPPI DEPARTMENT OF NATURAL RESOURCES

Bureau of Land and Water Resources

Southport Mall

P.O. Box 10631

Jackson, Mississippi 39209

WATER WELL DRILLERS LOG
TOM GRIFFITH

CODED

1/10/82
L 306
7/20/84

PLUMBING & WELL SERVICE INC. Monroe, Co. MS

7-20 1984
date well completed

320 MAYSON AVE.

county well located

COLUMBIA MS 39128

LANDOWNER: Prout Production

description of formations encountered

from

to

1515 Capital Towers

Rock, Chalk and Limestone

0' 490'

Jackson, MS 39201

Sand

440' 490'

(mailing address)

WELL LOCATION:

sec. 32 T. 14 N. R. 7 E
⑤ W
10 miles S of Abbeville
(distance) (direction) (nearest town)

WELL PURPOSE:

(home, irrigation, municipal, industrial)

WELL COMPLETION DATA:

- (1) diameter (inches) 3"
- (2) total depth (feet) 490'
- (3) static water level (feet) _____ below
above
top of ground.
- (4) casing Steel, 450'
(material) (depth)
3"
(size) if telescope see back.
- (5) screen 40', 450'
(length) (depth to top)
3", slotted steel
(size) (material)
- (6) pump air lift
(HP) (yield gpm)
diesel
(type power)
- (7) electric log NO
(yes or no)
N/A
(organization running log)
- (8) how well bottom plugged welded

CODED

DEPT. OF NATURAL RESOURCES
BUREAU OF LAND & WATER RESOURCES


AUG 7 1984

RECEIVED

DRILLERS REMARKS:

If well telescopes please sketch and show depths.

GROUND LEVEL

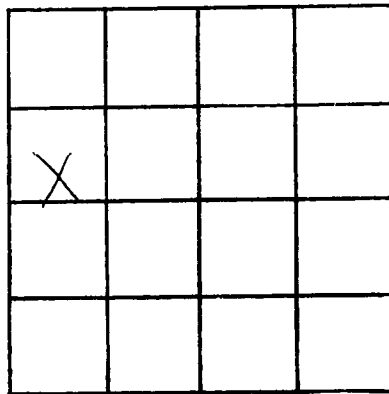

SECTION _____

Please indicate well location X.

ADDITIONAL INFORMATION

If more than one screen,
show locations of each on sketch.