

MONROE MISSISSIPPI BOARD OF WATER COMMISSIONERS

L 2000

7-13-65

WATER WELL DRILLERS LOG

Date: July 13, 1965, Driller: Herndon-Homan Well & Supply, Inc.
P. O. Box 42 County Monroe
SHANNON MISSISSIPPI 38868

(1) Owner of Land: Bradley Kumberg
 (Name)
Aberdeen, Miss.
 (Address)

(2) Location: 1/4, 1/4, Sec 20 T 14S R 7E
1 miles W of Aberdeen
 (distance) (direction) (Nearest Town)

(3) Topography: Flat
 (Hilly) (Flat) (Level)

(4) Purpose of Well: Domestic
 (Domestic Irrigation
 Municipal, Industrial, Other)

Description & Color of Materials Sand, Clay, Red Clay, Shell, etc.	Thick-ness Feet	Depth Feet
<u>surface sand & clay</u>	<u>0</u>	<u>40</u>
<u>Blue clay</u>	<u>40</u>	<u>56</u>
<u>sand & clay</u>	<u>56</u>	<u>98</u>
<u>Blue clay</u>	<u>78</u>	<u>130</u>
<u>Sand</u>	<u>130</u>	<u>240</u>
<u>Bottom</u>	<u>240</u>	


Information upon completion of well:

- (1) Diameter 4 inches.
- (2) Total Depth 240 feet.
- (3) Water Level 70 feet below top of ground.
- (4) Cased to 101, Size 4"
- (5) Screen: Size —, Length —
- (6) Were any formations sealed against pollution?
 yes, no.

If YES depth of formation 98'

Why surface & sand

Drillers Remarks:

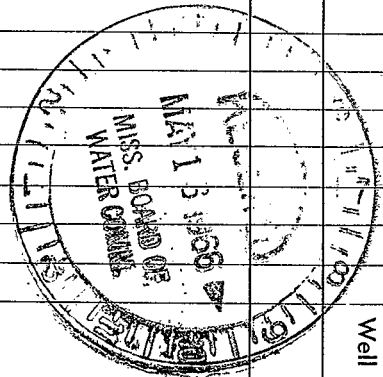

(Use Back Side)

Well No.

