

MONROE  
L 2008  
11-67

MISSISSIPPI  
BOARD OF WATER COMMISSIONERS  
416 North State Street  
Jackson, Mississippi 39201

WATER WELL DRILLERS LOG

date well completed 11/4 1967 firm name Herndon-Homan Well & Supply, Inc. (Monroe)  
SHANNON, MISSISSIPPI 38656 county well located


LANDOWNER:  
Calvin Clayton (cont)  
At 3 Abbeedah, Miss  
(mailing address)

description of formations encountered	from	to
<u>Surface sand/clay</u>	<u>0</u>	<u>20</u>
<u>Blue clay</u>	<u>20</u>	<u>90</u>
<u>Sand</u>	<u>90</u>	<u>200</u>
<u>Ball</u>	<u>200</u>	

WELL LOCATION:  
sec. 18 T. 14 N. R. 9 E  
S  
2 1/2 miles NW of Abbeedah  
(distance) (direction) (nearest town)

WELL PURPOSE: Home  
(home, irrigation, municipal, industrial)

- WELL COMPLETION DATA:
- (1) diameter (inches) 5"
  - (2) total depth (feet) 200'
  - (3) static water level (feet) 55' below top of ground.
  - (4) casing Steel, 22' 3"  
(material) (depth)  
— if telescope see back.  
(size)
  - (5) screen none  
(length) (depth to top)  
(size) (material)
  - (6) pump 1/3 5  
(HP) (yield gpm)  
electric  
(type power)
  - (7) electric log no  
(yes or no)  
(organization running log)
  - (8) how well bottom plugged open

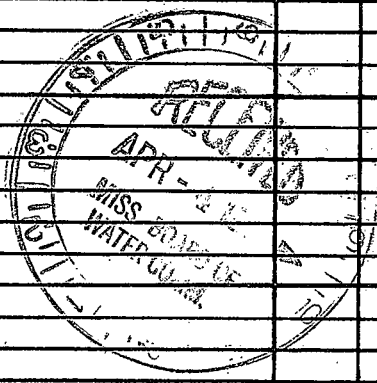

DRILLERS REMARKS:

If well telescopes please  
sketch and show depths.

GROUND LEVEL


SECTION \_\_\_\_\_

Please indicate well location X.

ADDITIONAL INFORMATION

If more than one screen,  
show locations of each on sketch.